## COMSTOCK AND DAVIS INC.

SURVEYD FOR: Robert Walker


DESCRIPTION: (From Tax Statement)

Except the West 1213.1 feet of Section 2, Township 29, Range 23,

the North quarter of Lot 26, Saint Paul Park.

Ramsey County, Minnesota

Survey based on survey and irons by Charles O. Georgi Company dated June 8, 1967.

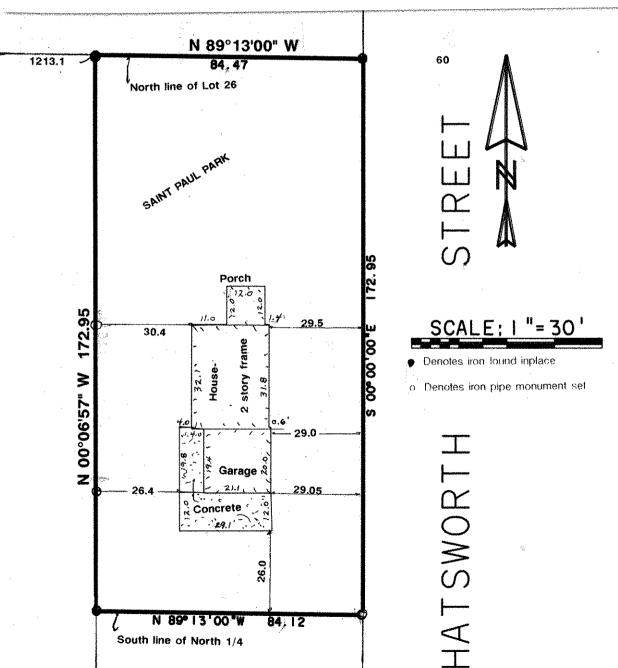

I hereby certify that this survey, plan plat, preliminary plat or report was prepared by me or under my direct supervision and that I am a duly Registered Land Surveyor under the laws of the State

of Minnesota. Dona Ble Schwell

10459

R-91811

Reg. No.

Date

Job No.

Book No.