


# GOMSTOCK AND DAVIS INC.

For: Rick Gierdal

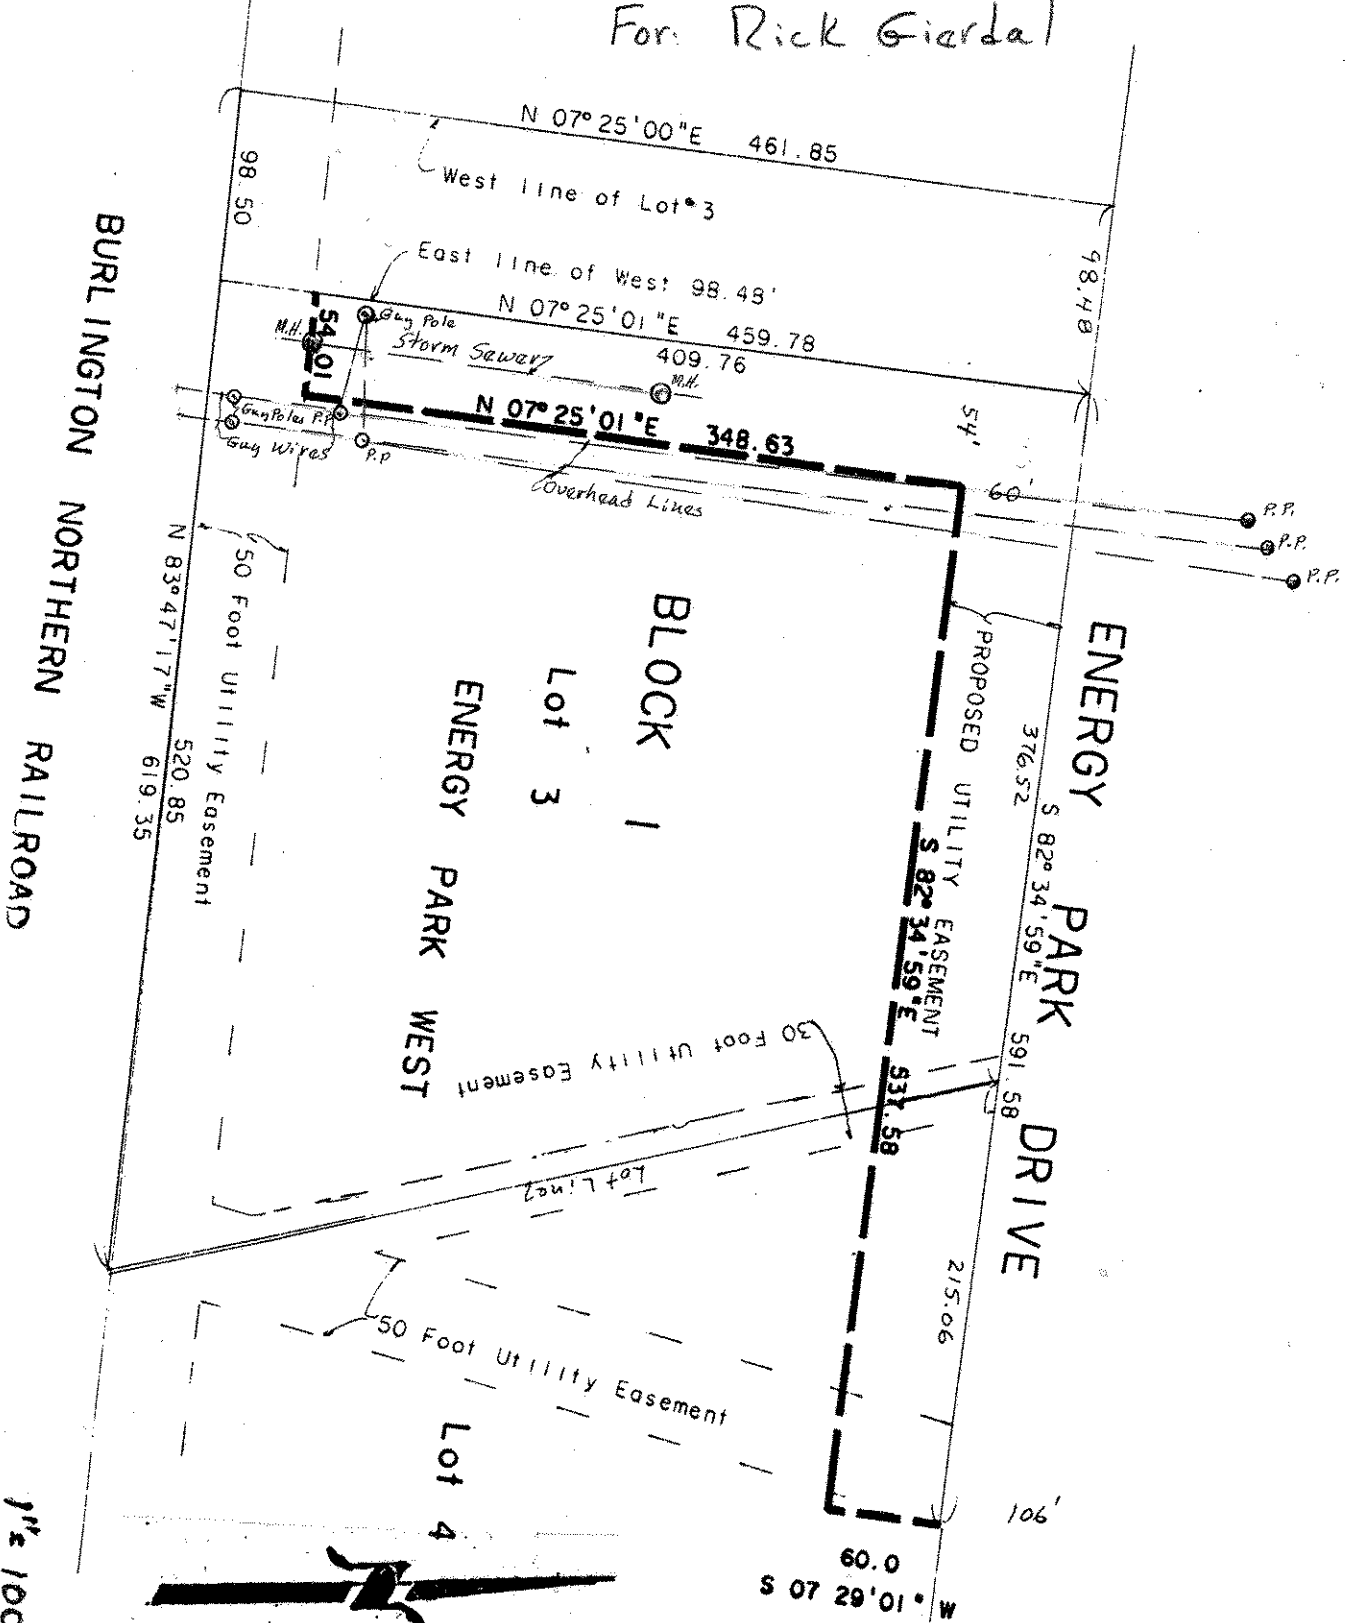

I hereby certify that this survey, plan plat, preliminary plat or report was prepared by me or under my direct supervision and that I am a duly Registered Land Surveyor under the laws of the State of Minnesota.