


GOMSTOCK AND DAVIS INC.

SURVEYED FOR: Total Asphalt as per Ed Kieger

DESCRIPTION:

North line of Lots 5 and 6, Block 25, Sarah's Out Lots.
Ramsey County, Minnesota

o - Denotes iron pipe monument set

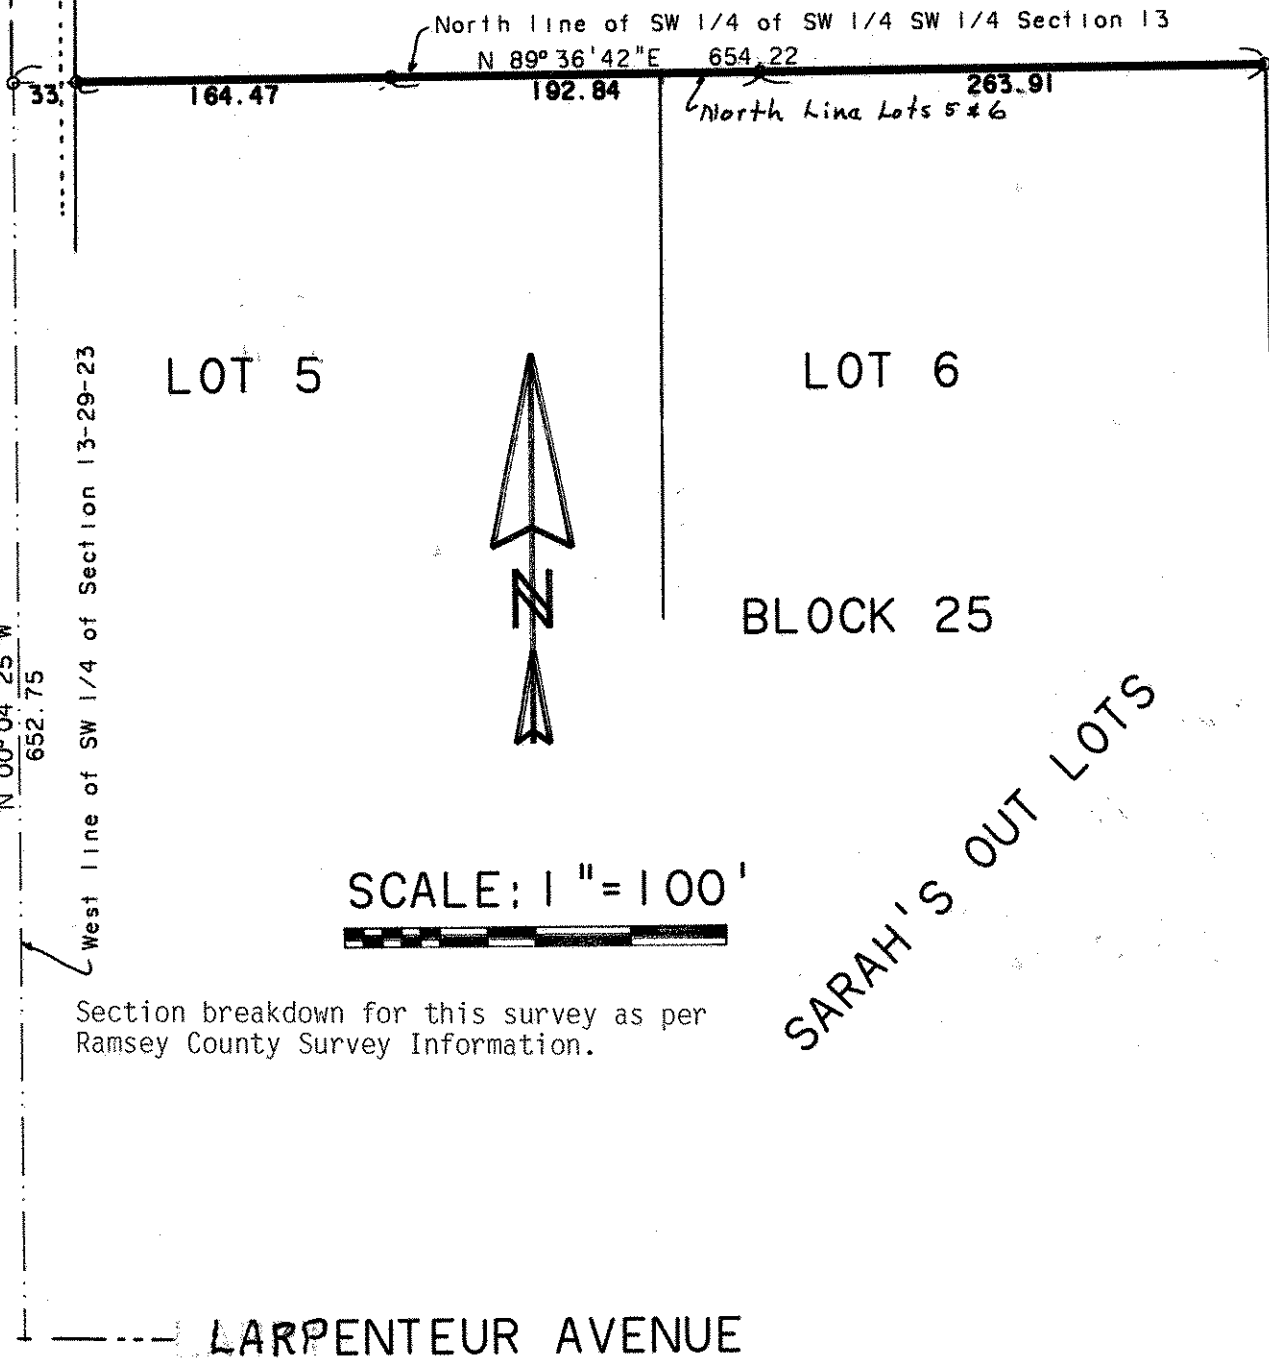

Section breakdown for this survey as per Ramsey County Survey Information.

I hereby certify that this survey, plan plat, preliminary plat or report was prepared by me or under my direct supervision and that I am a duly Registered Land Surveyor under the laws of the State of Minnesota.

10459	4/19/91	R-91770	
Reg. No.	Date	Job No.	Book No.