

# GOMSTOCK AND DAVIS INC.

3092 N. LEXINGTON AVE. ST. PAUL, MN. 55113 483-4408


SURVEYED FOR: EVELYN WORTMAN

DESCRIPTION: Lot 11, Block 34, Auerbach and Hand's Addition, Ramsey County, Minnesota.

SCALE: 1" = 30'

- IF • Denotes Iron Pipe Found
- Denotes Iron Pipe Set

WESTERN AVENUE  
33

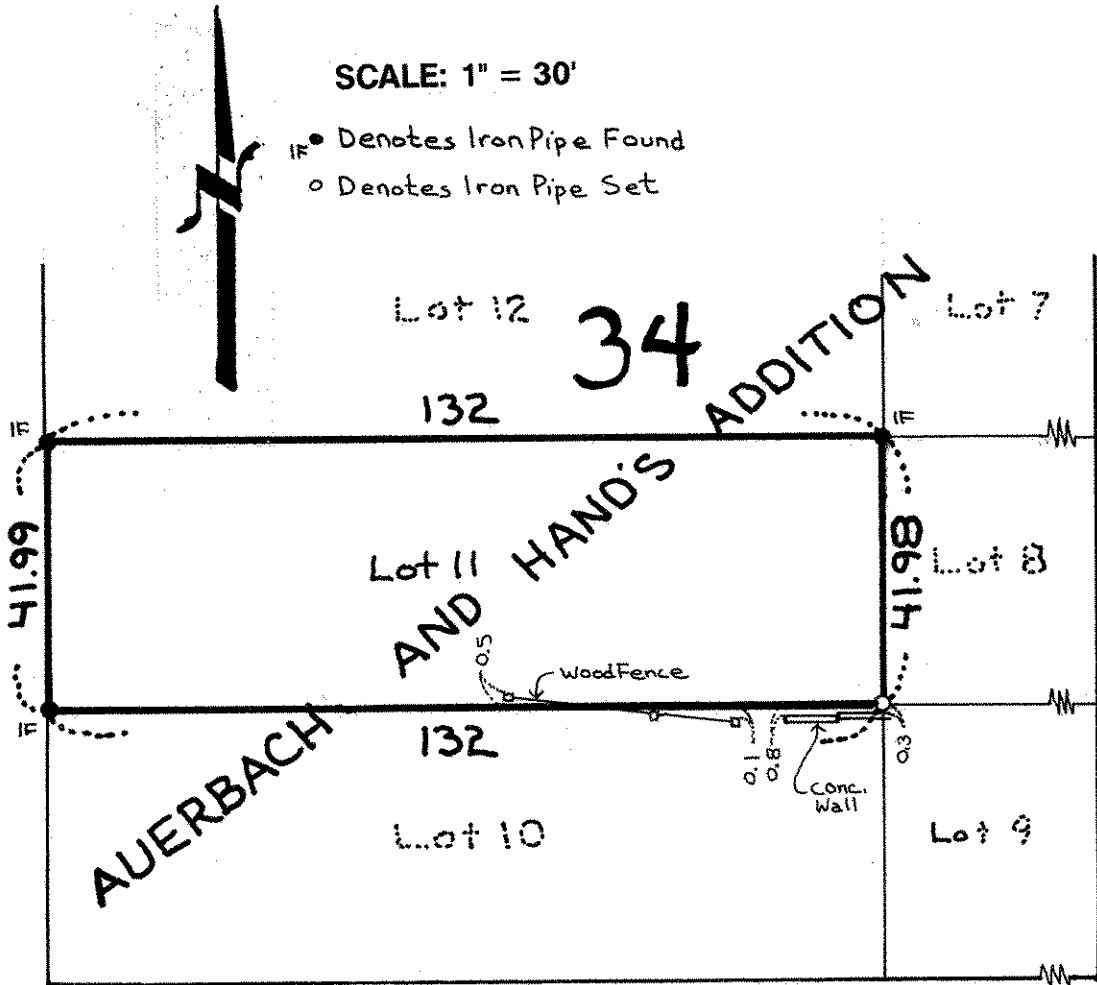

LAWSON AVENUE  
60

VIRGINIA STREET

I hereby certify that this survey, plan plat, preliminary plat or report was prepared by me or under my direct supervision and that I am a duly Registered Land Surveyor under the laws of the State of Minnesota.

Donald W. Schmidt      10459      6/8/93      931310  
Reg. No.      Date      Job No.      Book No.