

COMSTOCK AND DAVIS INC.


SURVEYED FOR: Gordy Howe

Page 1 of 2

Part of Outlot B, Ferriswood

See attached 8 1/2" by 11" certificate for Description

VOID

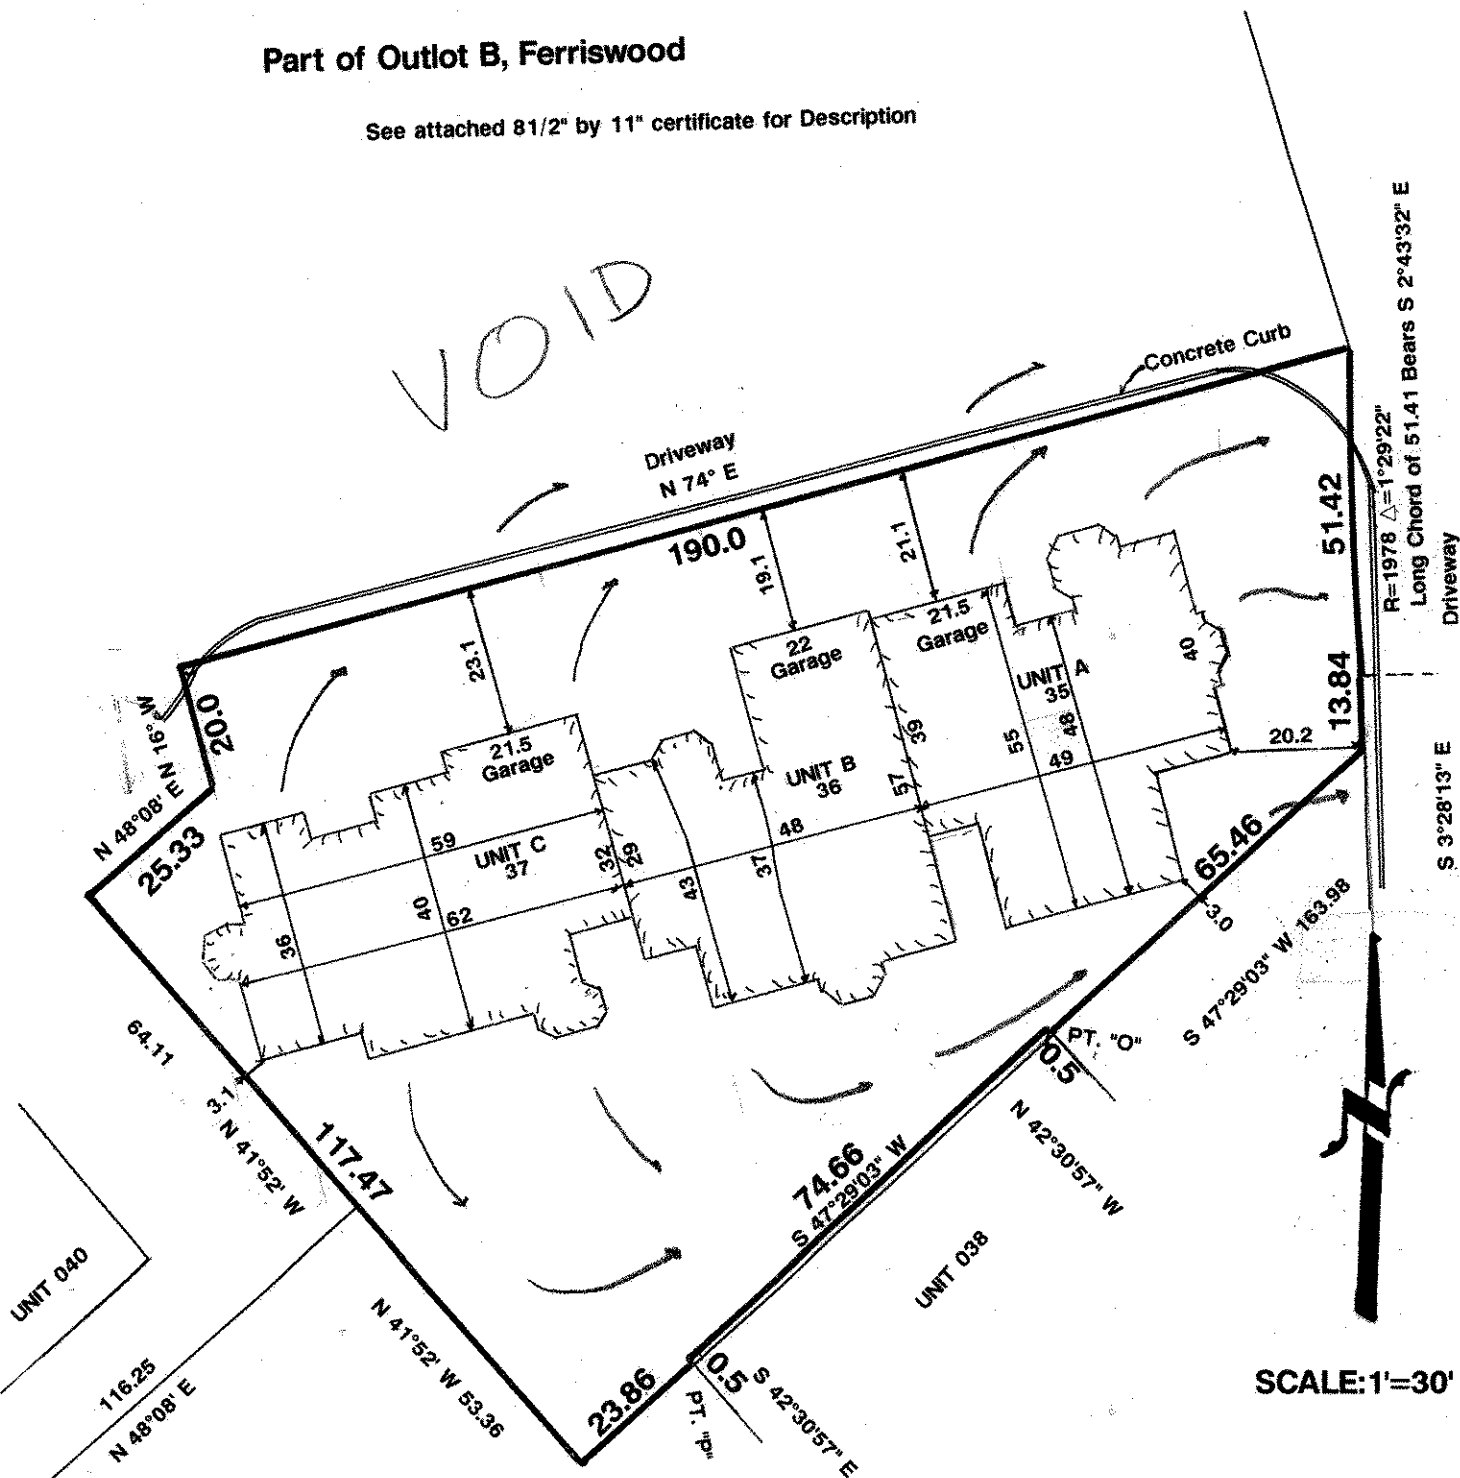

I hereby certify that this survey, plan plat, preliminary plat or report was prepared by me or under my direct supervision, and that I am a duly Registered Land Surveyor under the laws of the State of Minnesota.

Conrad Schuel

10459

2/21/92

R-91854

Reg. No.

Date

Job No.

Book No.