

COMSTOCK AND DAVIS INC.


3092 N. LEXINGTON AVE. ST. PAUL, MN. 55113 483-4408

Page 1 of 2

SURVEYED FOR: Gordie Howe

DESCRIPTION: Part of Outlot B, Ferriswood

See attached 8-1/2" by 11" certificate for Description

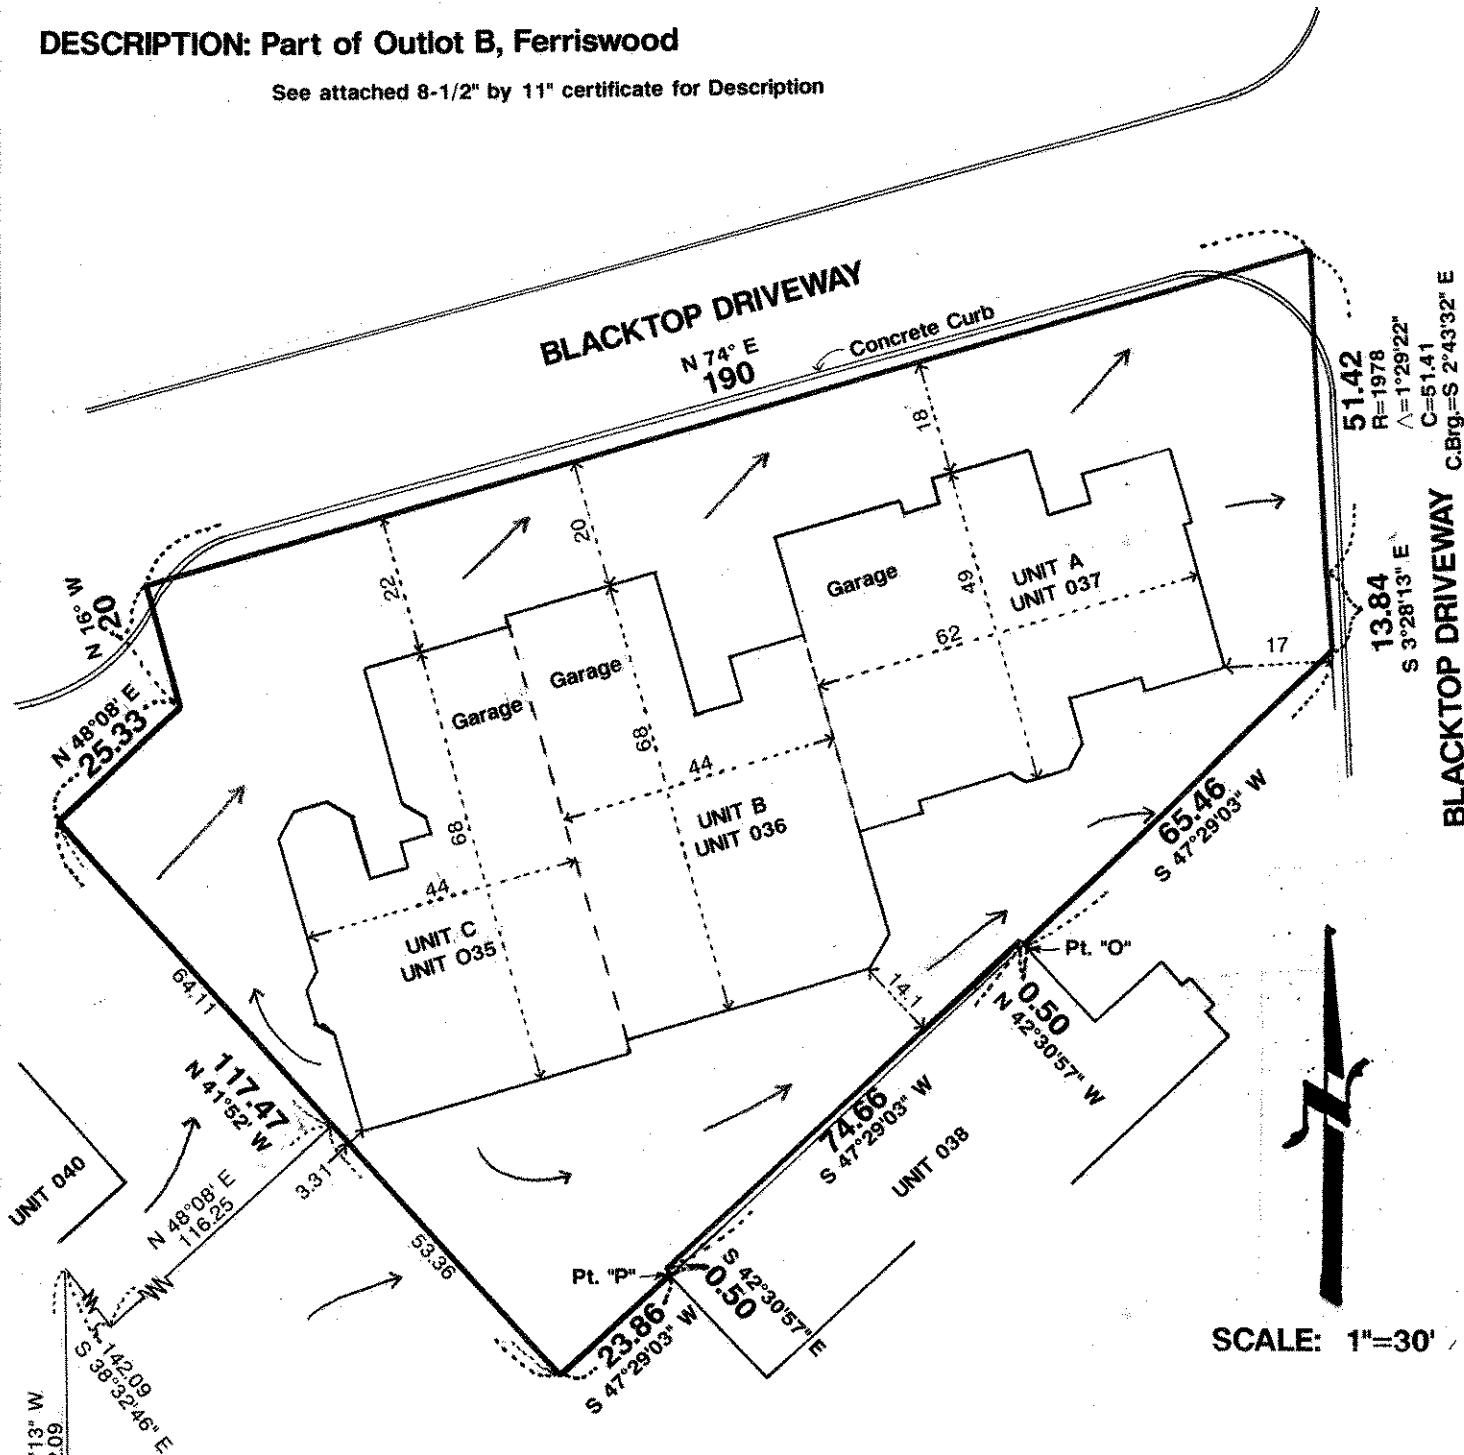

I hereby certify that this survey, plan plat, preliminary plat or report was prepared by me or under my direct supervision and that I am a duly Registered Land Surveyor under the laws of the State of Minnesota.

Gene Cole

Reg. No. 10459 Date 4/21/92 Job No. R-91854 Book No.