


# COMSTOCK AND DAVIS INC.

3092 N. LEXINGTON AVE. ST. PAUL, MN. 55113 483-4408

**SURVEYED FOR:** Gordie Howe  
**DESCRIPTION:** Part of Outlot B, Ferriswood

See attached 8-1/2" by 11" certificate for description.

Arrows indicate direction of drainage.

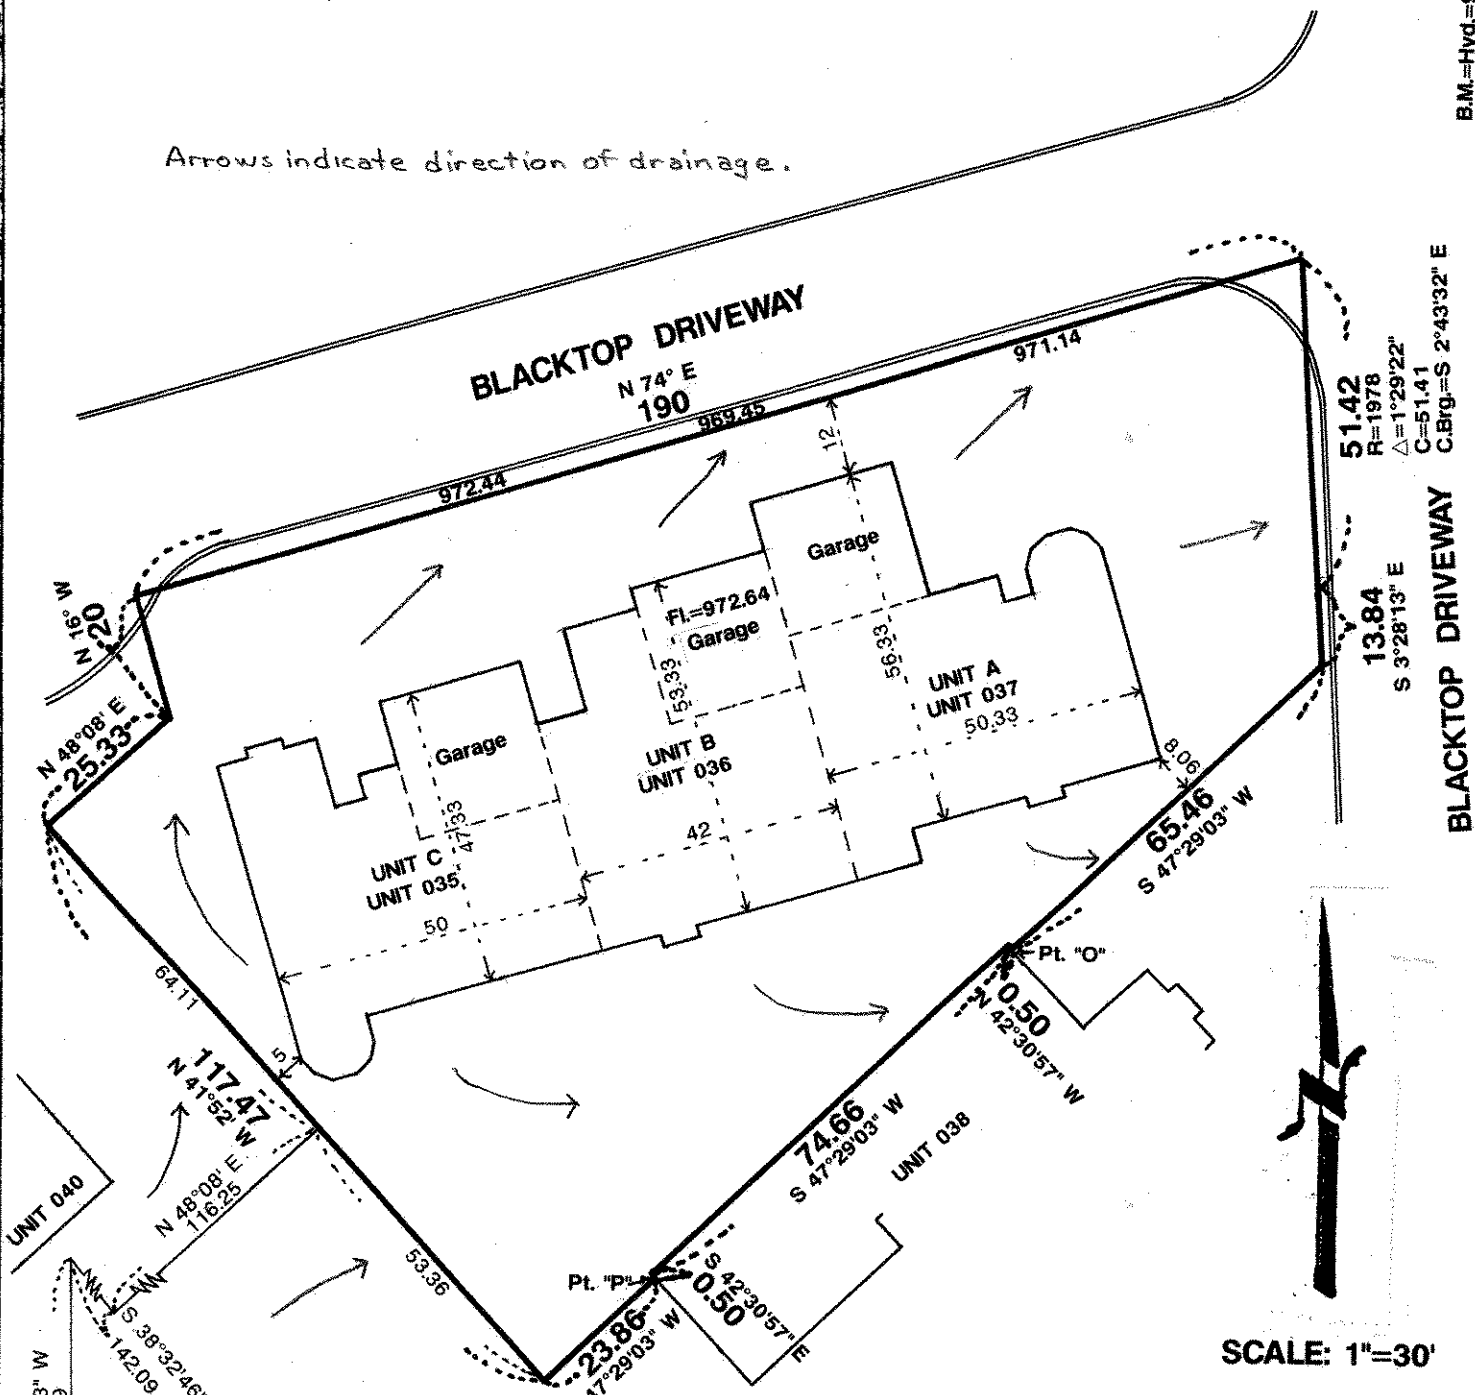

B.M.=Hyd.=966.62

51.42  
R=1978  
Δ=1°29'22"  
C=51.41  
C.Brg.=S 2°43'32" E

SCALE: 1"=30'

I hereby certify that this survey, plan plat, preliminary plat or report was prepared by me or under my direct supervision and that I am a duly Registered Land Surveyor under the laws of the State of Minnesota.