

10 24-23
GOMSTOCK AND DAVIS INC.

3092 N. LEXINGTON AVE. ST. PAUL, MN. 55113 483-4408

SURVEY FOR: Norvin Henrichs


DESCRIPTION: (Easement)

The North 13 feet of the South 49 feet of the West 6 feet of the East 126 feet of Lot 6 and,
That part of the West 7 feet of the East 126 feet of Lot 6 lying North of the South 49 feet,
All in Block 1, Verde Haven, Ramsey County, Minnesota.

o Denotes iron pipe monument set and marked #10459



SCALE: 1 inch = 20 feet

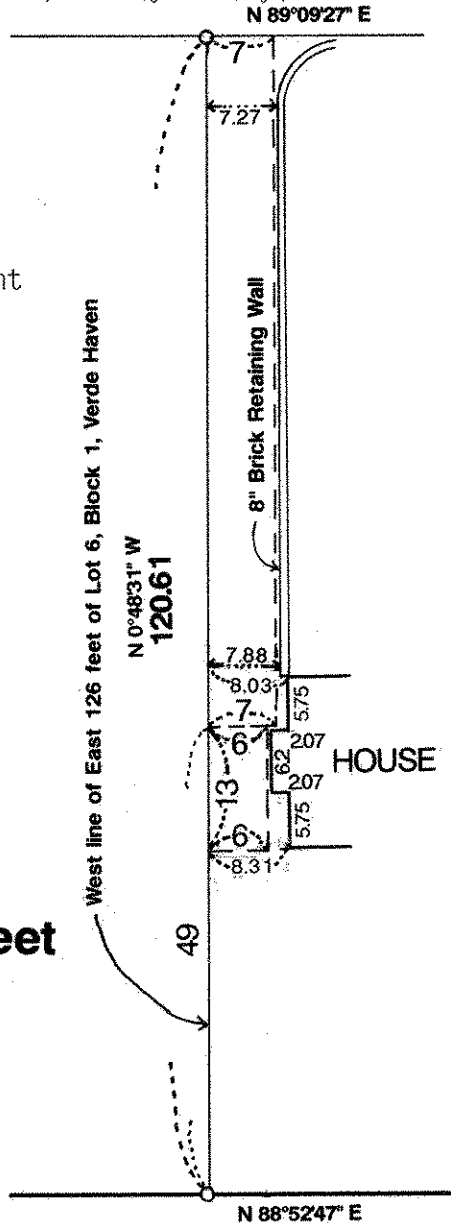

COUNTY ROAD B-2

I hereby certify that this survey, plan plat, preliminary plat or report was prepared by me or under my direct supervision and that I am a duly Registered Land Surveyor under the laws of the State of Minnesota.

10459
Reg. No.

7/10/92
Date

R-92817
Job No.

Book No.