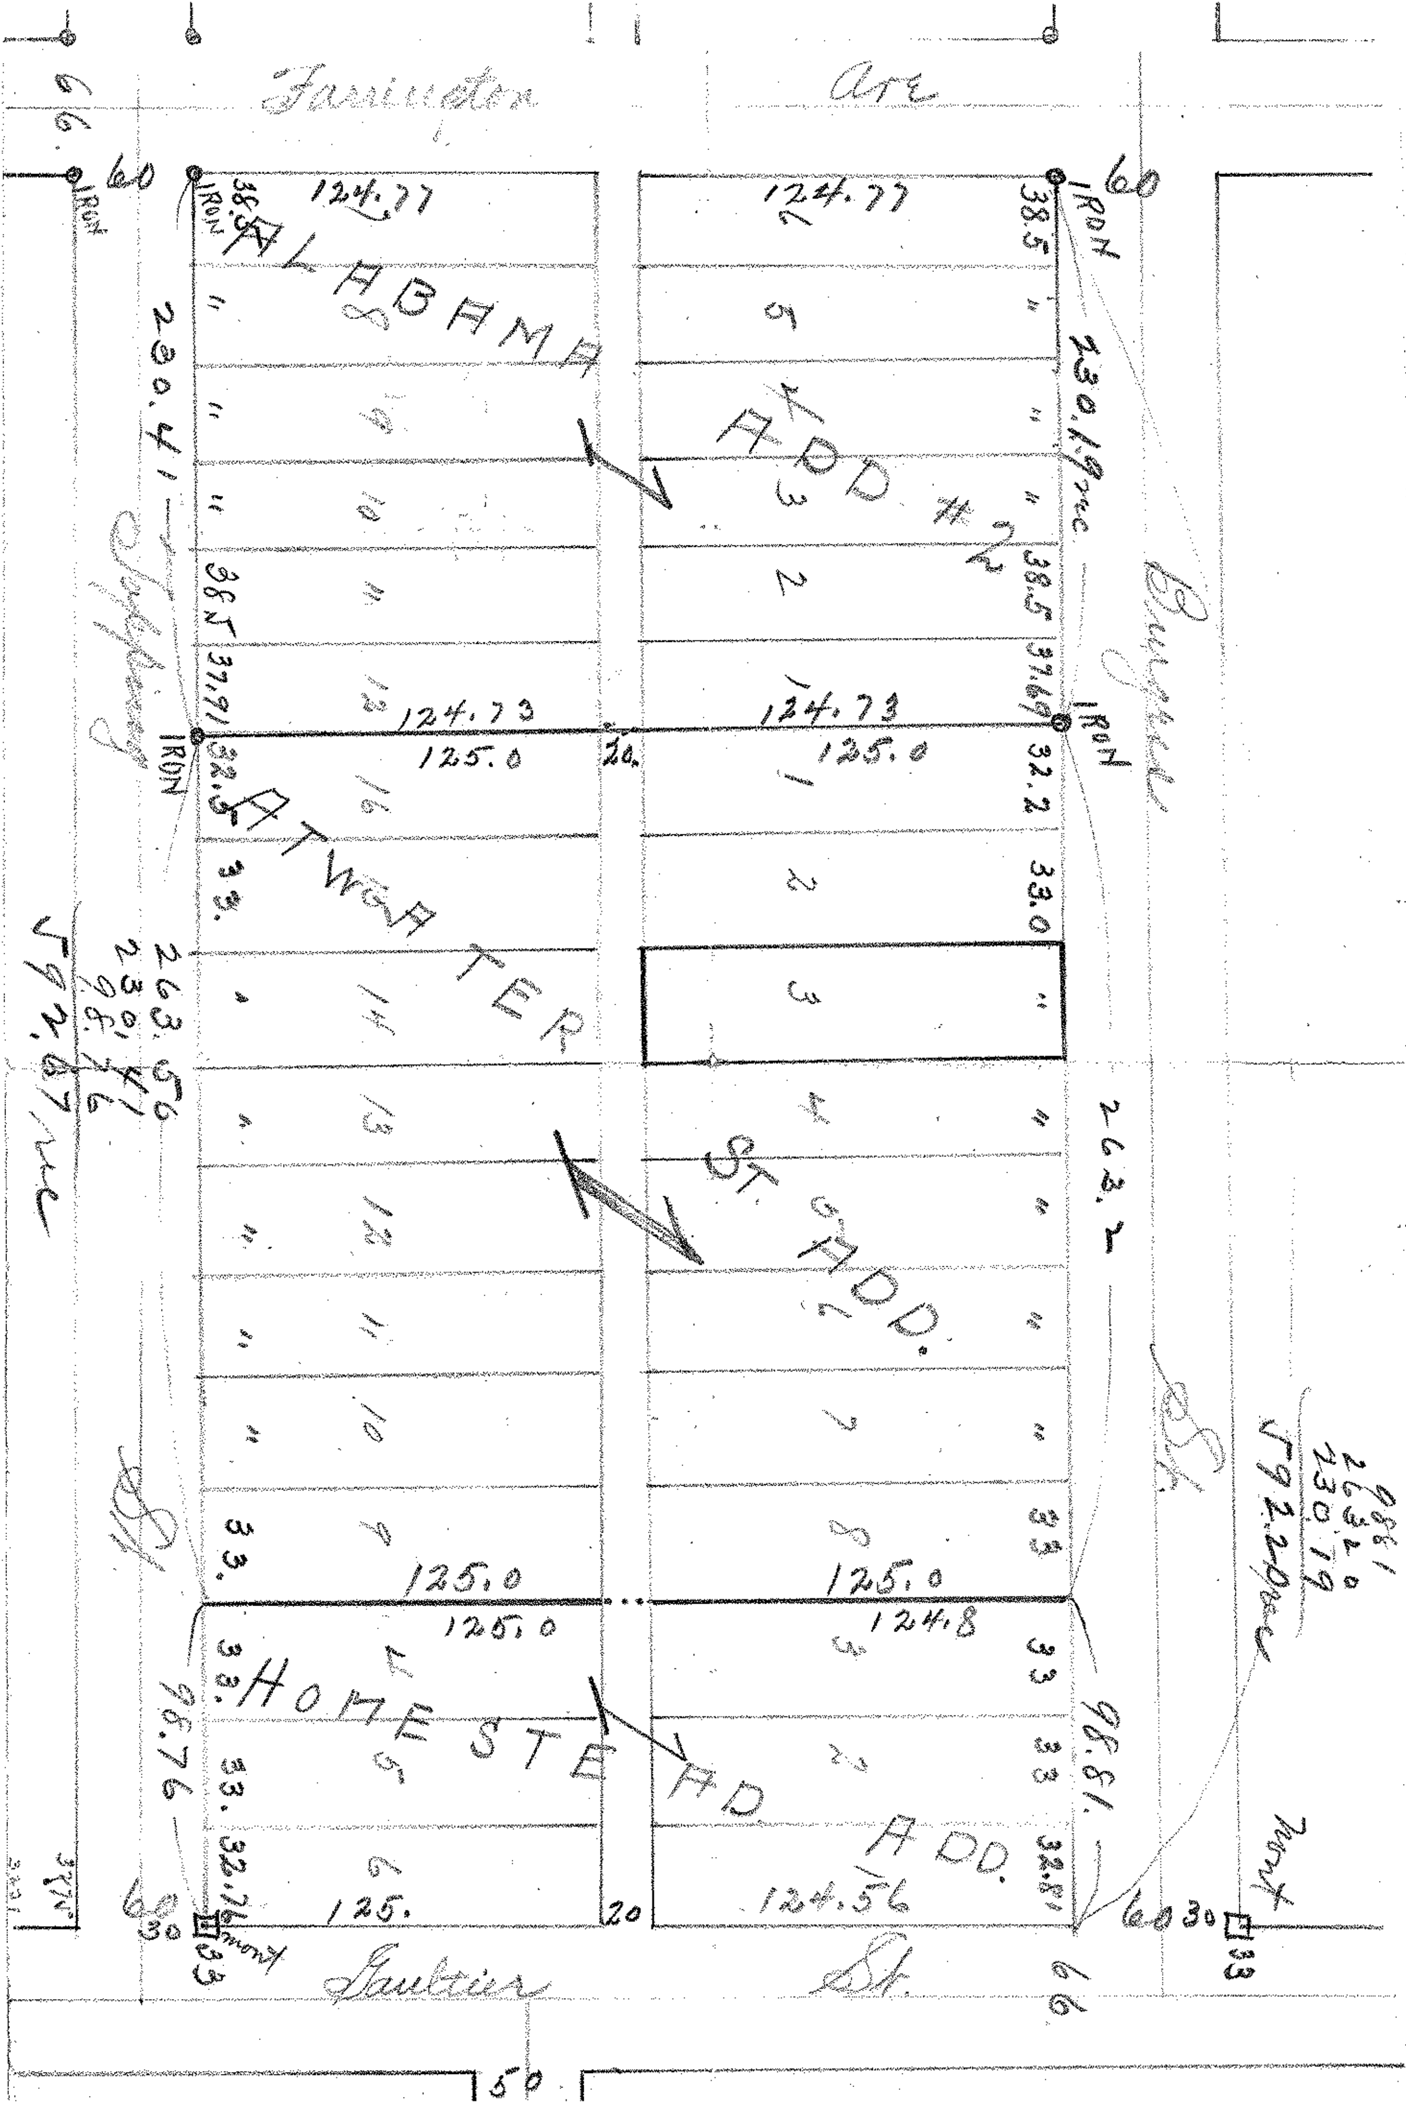
Farmington Ave
ALABAMA ADD #2
ATWATER ST. ADD.
HOMESTEAD ADD.
Gaultier St.
124.77
124.73
125.0
124.8
124.56
125.
230.41
230.19
263.56
263.2
98.76
98.81
38.5
37.91
37.69
32.2
33.0
32.76
32.81
20
50
60
66
30
33
IRON
mont