NW 5 29 23

Certificate of Survey

From the office of

GEORGI- SCHMIDT & ASSOC. INC.

3092 No. Lexington Ave., Roseville, Mn. 55113
LAND SURVEYING
483-4408

I Hereby Certify that this plat shows a survey made by me of the property described on this plat, and that the corners are correctly placed as shown, and that all locations have been correctly shown.

Job Number: 119

Surveyed For Greg Preese

Date October 1978

Scale 1"=60'

By Arnold W Schmidt
REGISTERED LAND SURVEYOR

Description:

That part of the NW 1/4 of Section 5, T29N, R23W, described as follows: Commencing at a point in the center line of State Highway #63 distandt 1316 feet North-Northeasterly measured along said center line from the South line of said NW 1/4; thence continuing NE 1/y along said center line 75 feet; thence SE 1/y at right angles 290.40 feet; thence SW 1/y at right angles 75 feet; thence NW 1/y at right angles 290.40 feet to the beginning. Subject to highway easements and other easements of record.
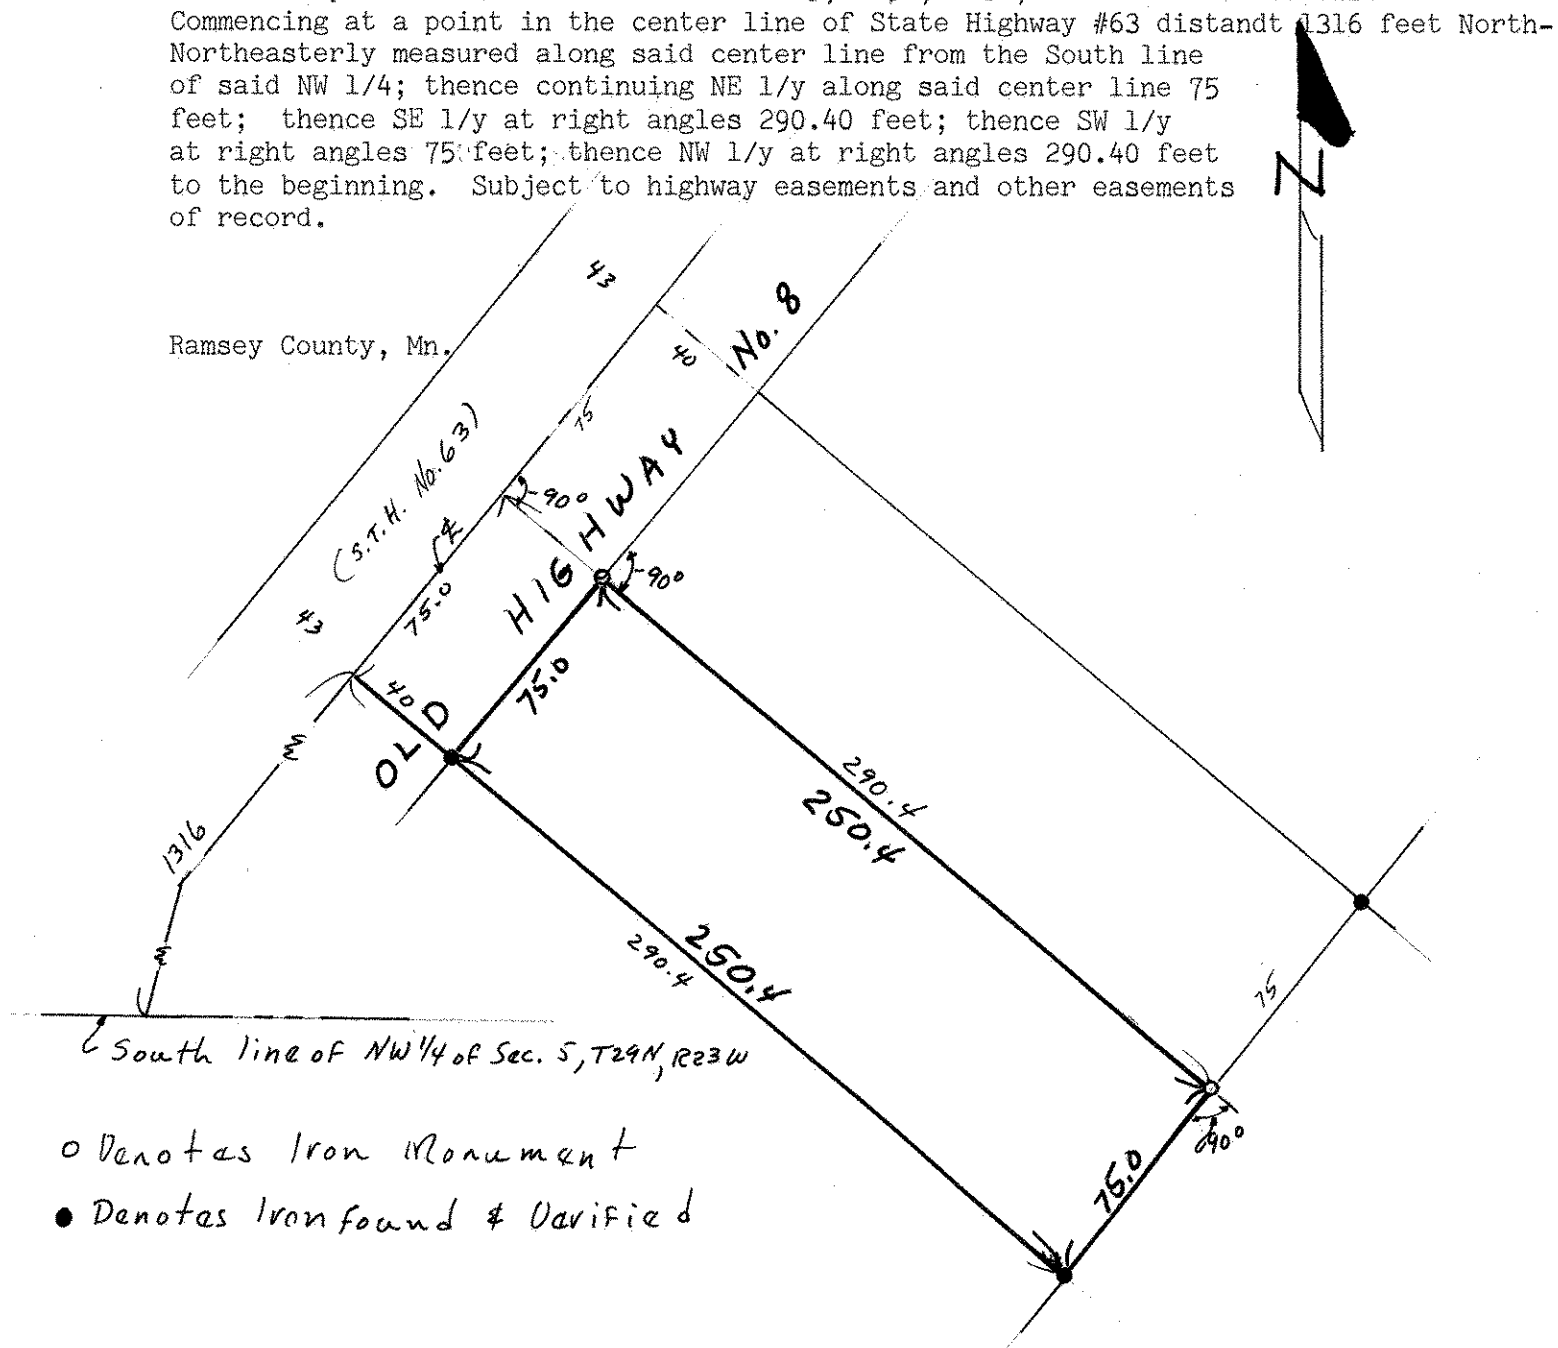
Ramsey County, Mn.