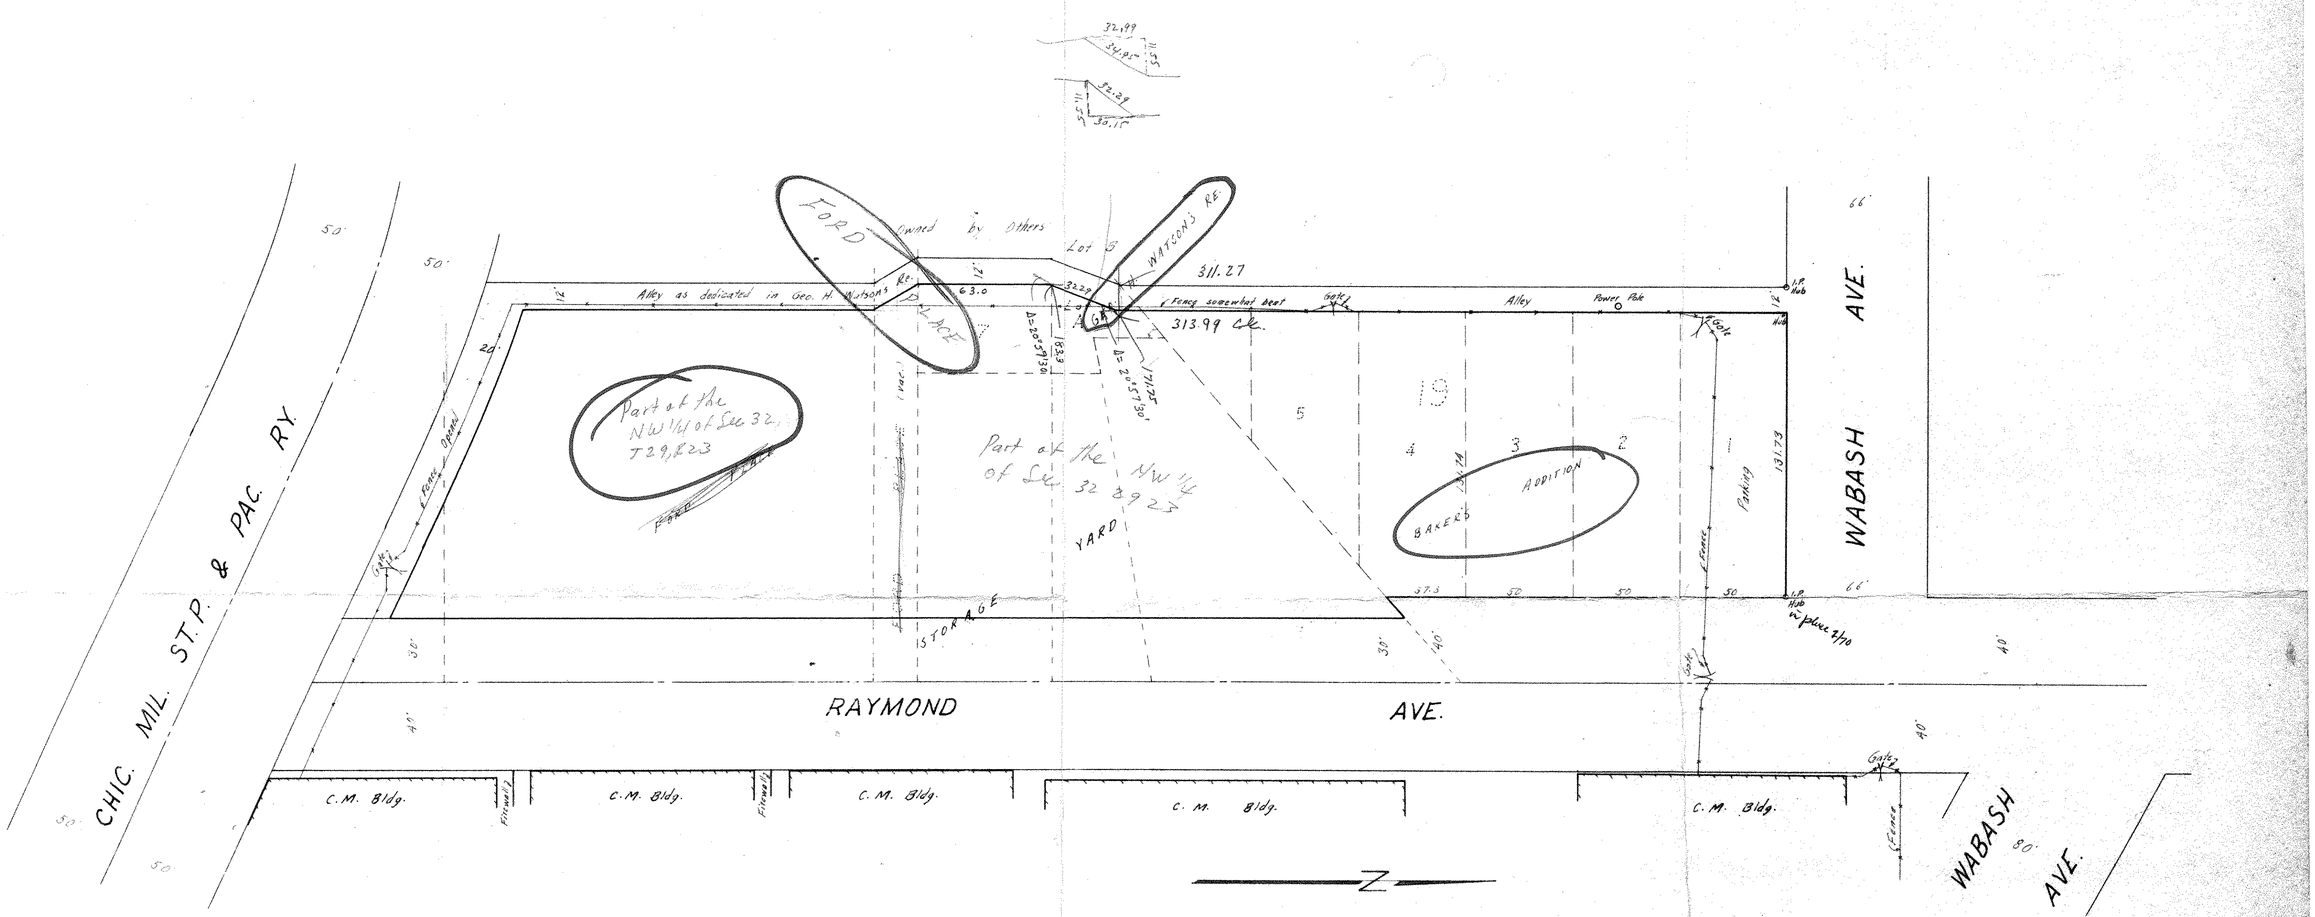

NOTE:

Alley to West is open and is easily accessible and adjoins others.
Alley to South is fenced as shown, not graded and partly filled
Raymond Ave. is fenced off and used for storage area.
This site map shows the location of some features. It is not intended to be a complete site location map. For example the railroad tracks are not shown.

SITE MAP

WALDORF PAPER PRODUCTS COMPANY

2250 WABASH AVE. ST. PAUL MINN.

SCALE 1" = 40'

Charles O. Georgi Company
Civil Engineering & Land Surveying
2215 W. Co. Rd. B St. Paul 13, Minn. May 1964

62 B