

Certificate of Survey

From the office of GEORGI-SCHMIDT & ASSOC. INC.

3092 No. Lexington Ave., Roseville, Mn. 55113

LAND SURVEYING

483-4408

I Hereby Certify that this plat shows a survey made by me of the property described on this plat, and that the corners are correctly placed as shown.

Job Number: 1415

Surveyed For Randall Harwood

Date June 23, 1983

Scale 1" = 60'


By Donald W. Schmidt
REGISTERED LAND SURVEYOR

#10459

2/2/87 Add Houses

Description:

Lot 12,
Block 1,
Korrol Shores Addition,
Ramsey County, Minn.

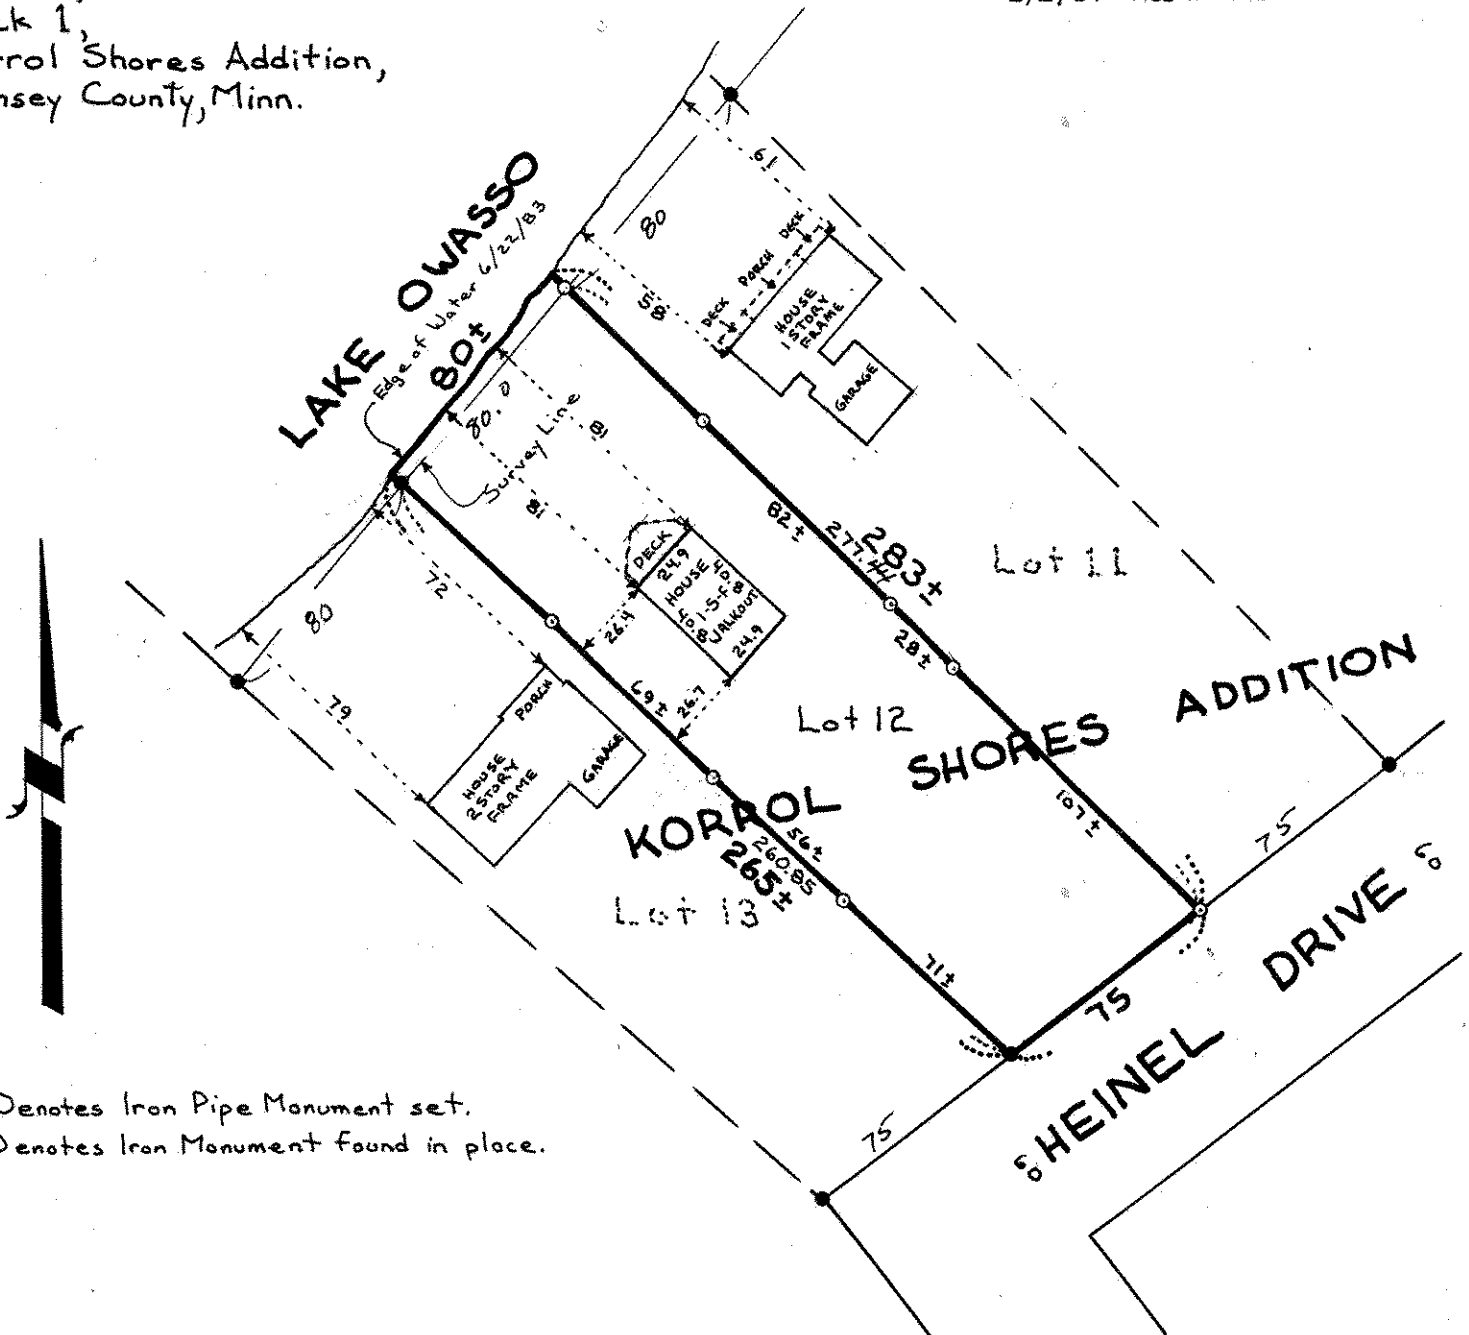

- o Denotes Iron Pipe Monument set.
- Denotes Iron Monument found in place.