SE 12 29 23

Certificate of Survey

From the office of
GEORGI- SCHMIDT & ASSOC. INC.
3092 No. Lexington Ave., Roseville, Mn. 55113
LAND SURVEYING
483-4408

I Hereby Certify that this plat shows a survey made by me of the property described on this plat, and that the corners are correctly placed as shown, and that all locations have been correctly shown.

Job Number: 312

Surveyed For James Harrington

Date April 19, 1979

Scale 1"=30

By Donald W. Schmidt
REGISTERED LAND SURVEYOR

Description:
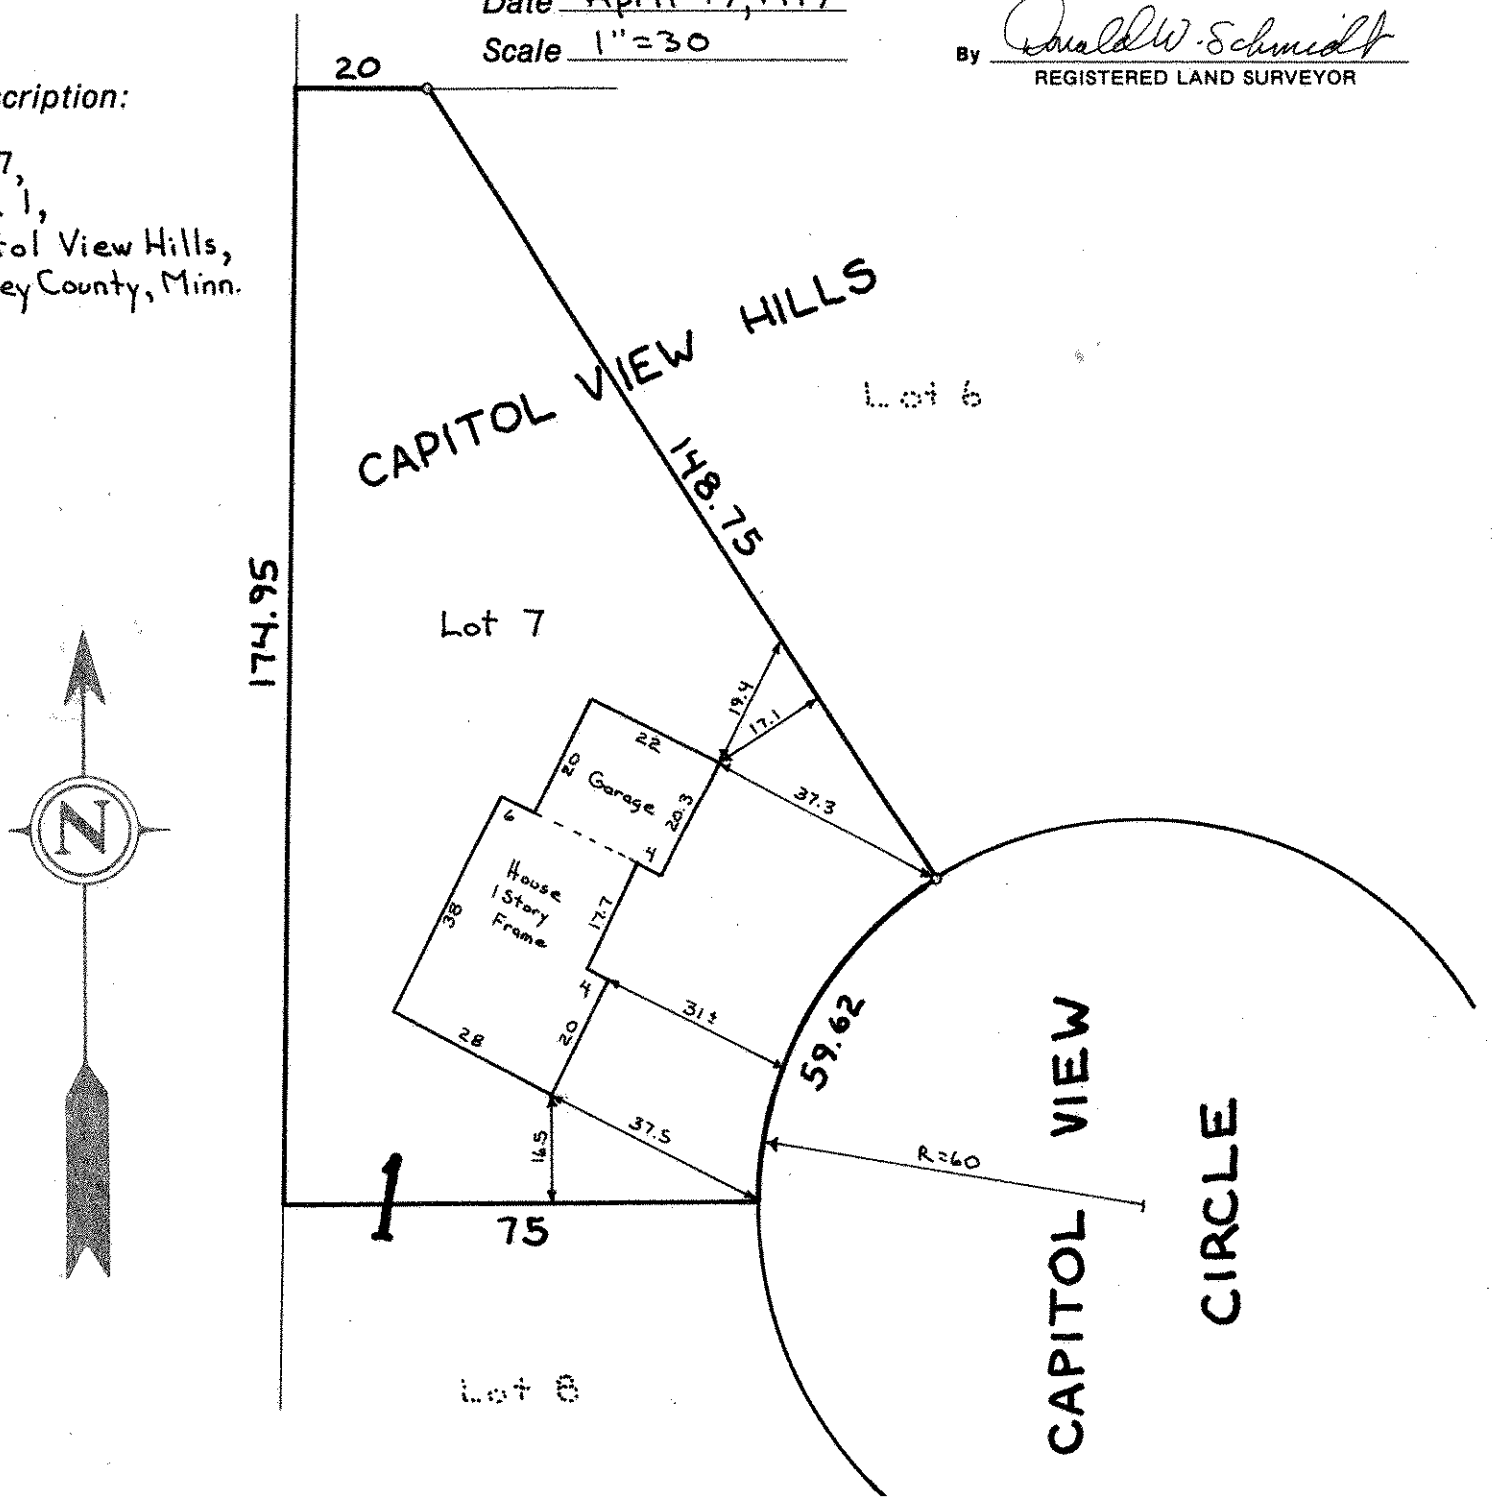
Lot 7,
Block 1,
Capitol View Hills,
Ramsey County, Minn.