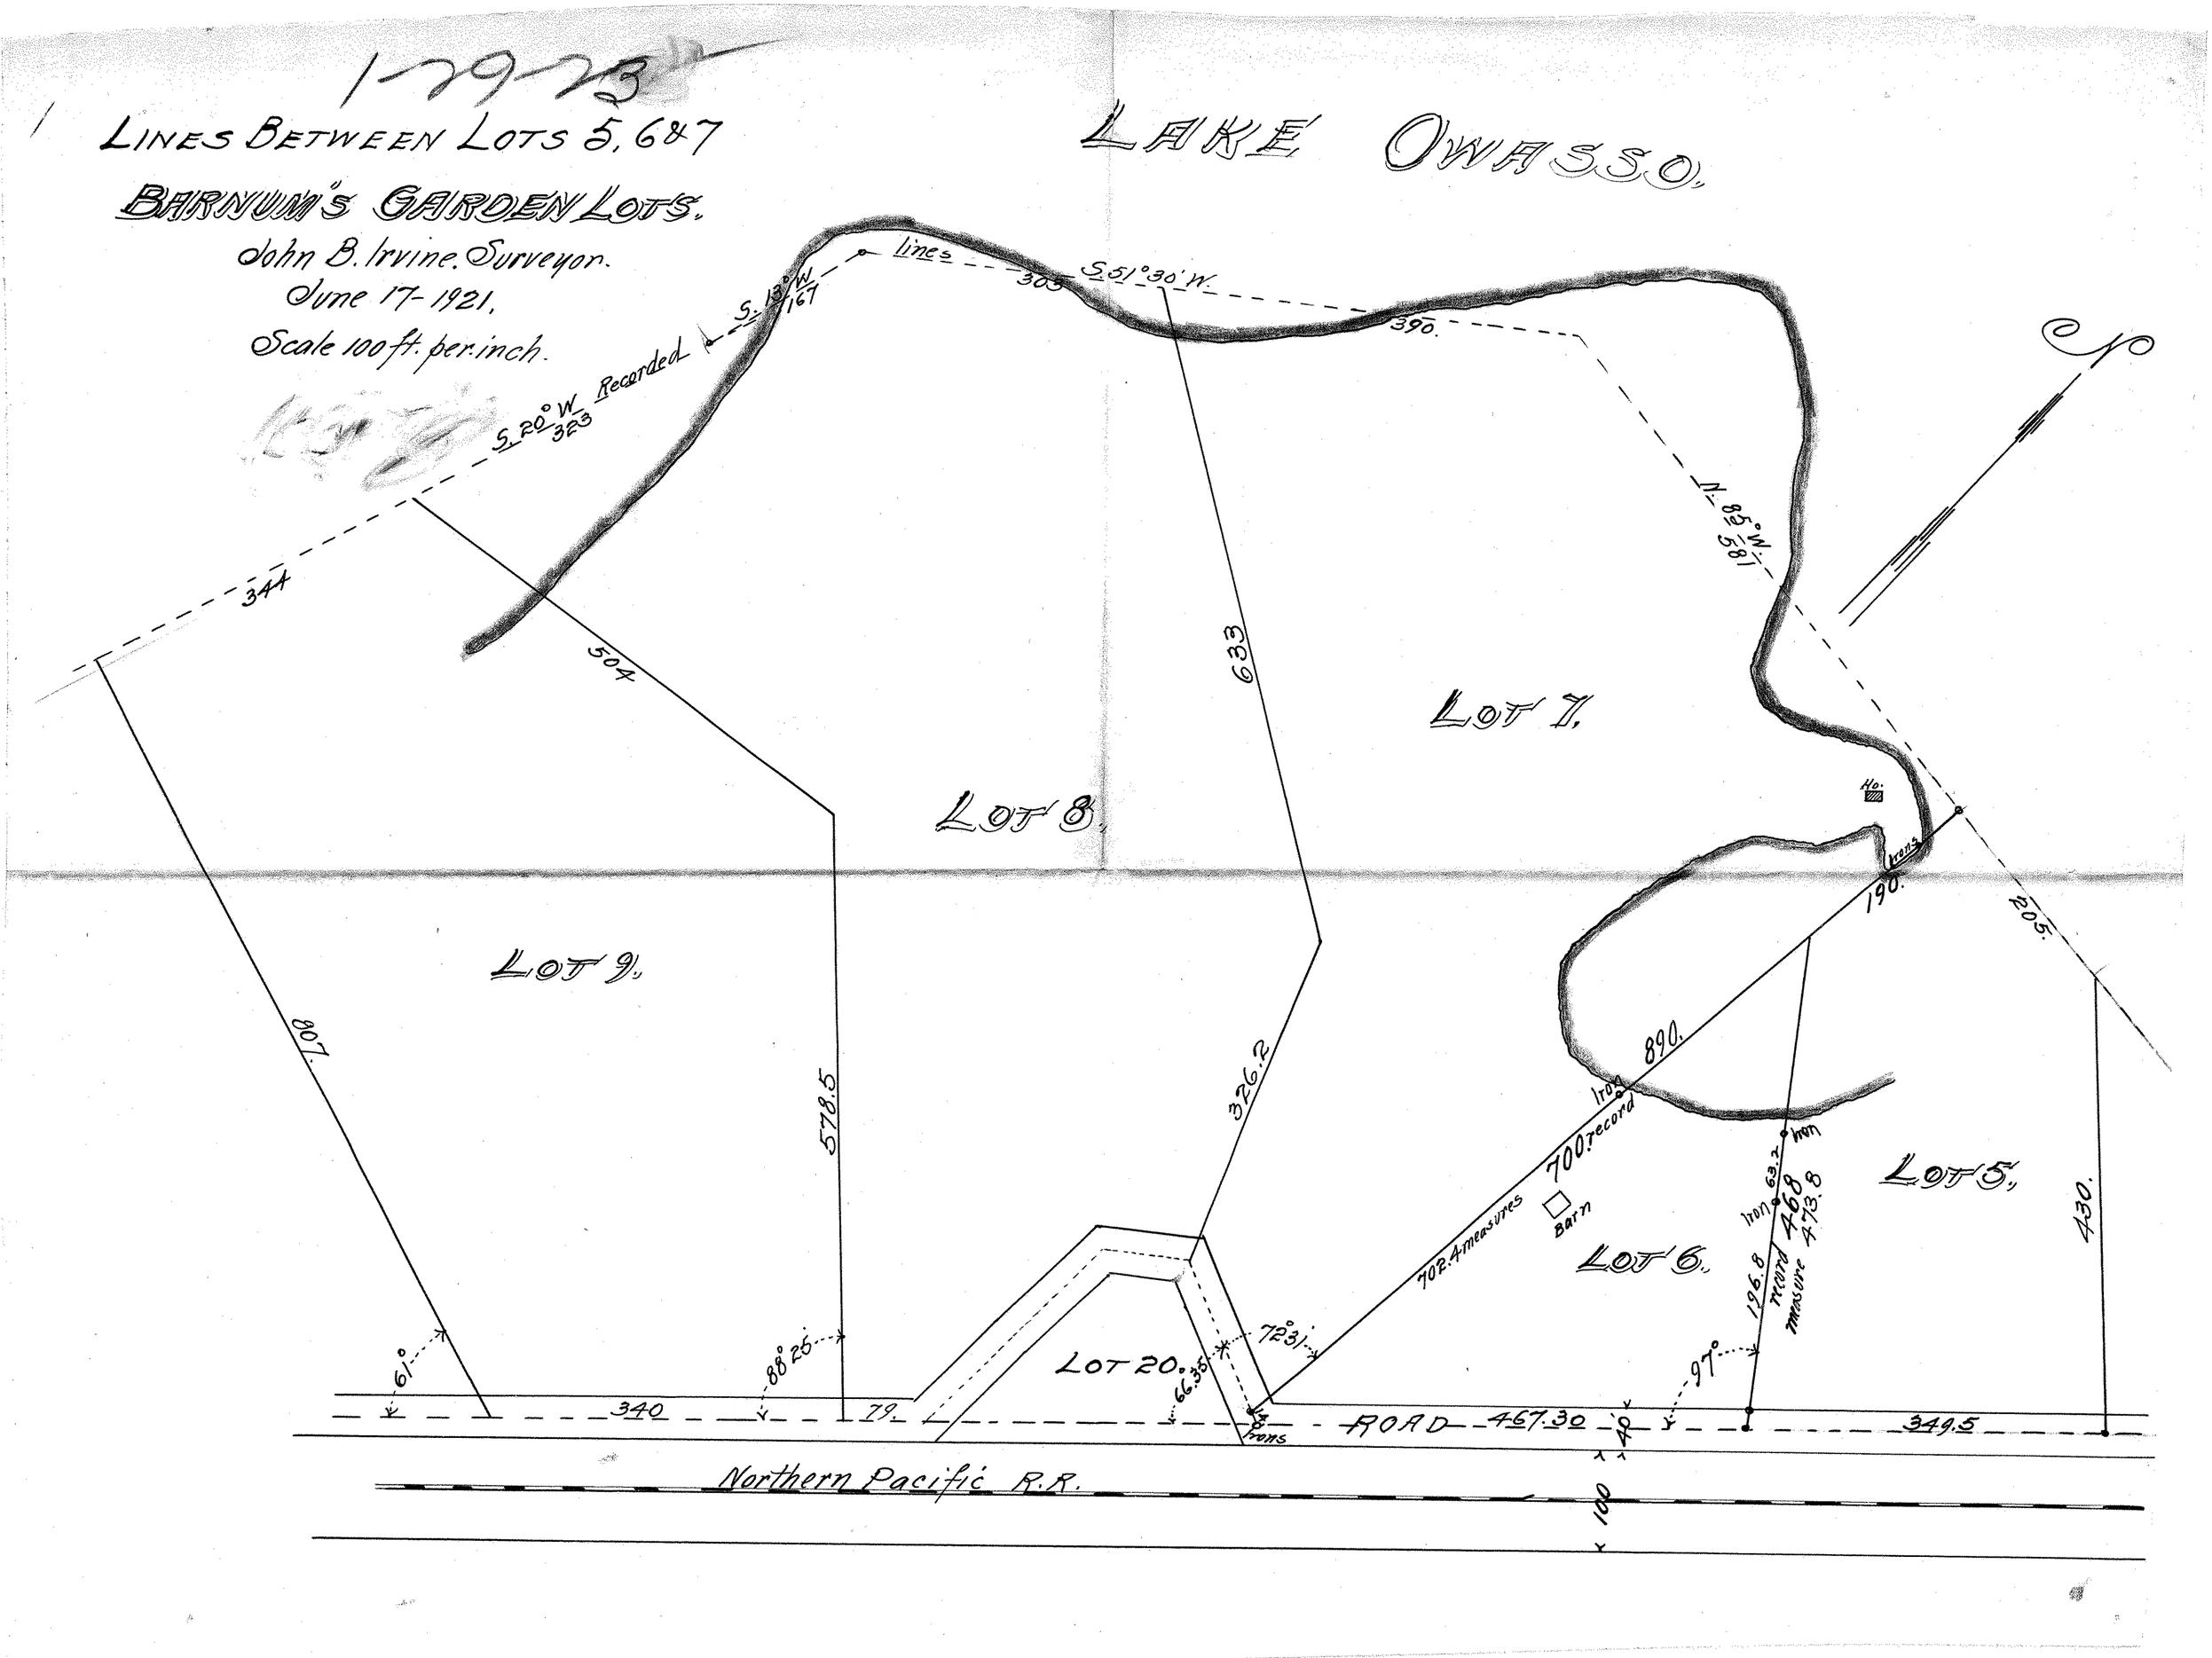

1-29-23
LINES BETWEEN LOTS 5, 6 & 7
BARNUM'S GARDEN LOTS.
John B. Irvine. Surveyor.
June 17-1921.
Scale 100 ft. per inch.
LAKE OWASSO.
lines
S. 13° W. 167
S. 51° 30' W.
303
390.
S. 20° W. 323 Recorded
344
504
633
N. 85° W. 581
LOT 7.
LOT 8.
LOT 9.
LOT 5.
LOT 6.
LOT 20.
807.
578.5
326.2
890.
190.
205.
430.
Iron
700 record
702.4 measures
Barn
63.2
468
473.8
196.8
record
measure
61°
88° 25'
72° 31'
66.35
97°
340
79.
ROAD
467.30
349.5
40
100
Northern Pacific R.R.