SE 8, 29, 23

FROM THE OFFICE OF

CHARLES O. GEORGI COMPANY

2215 West County Road B — Saint Paul, Minnesota 55113

REGISTERED CIVIL ENGINEER AND LAND SURVEYOR

Certificate of Survey

File – "Agar"

For: J. S. Lind

I Hereby Certify that this plat shows a building location survey made by me on the property described on this plat, and that all locations, have been correctly shown. No corners placed herewith. House location to scale. 5/13 – Revised descriptions and dwg. 3/15/67 Exclude Fulham St. Layout per owners request.

Date 25, APRIL 1969

Scale 1" = 50'

By Charles O. Georgi
REGISTERED LAND SURVEYOR
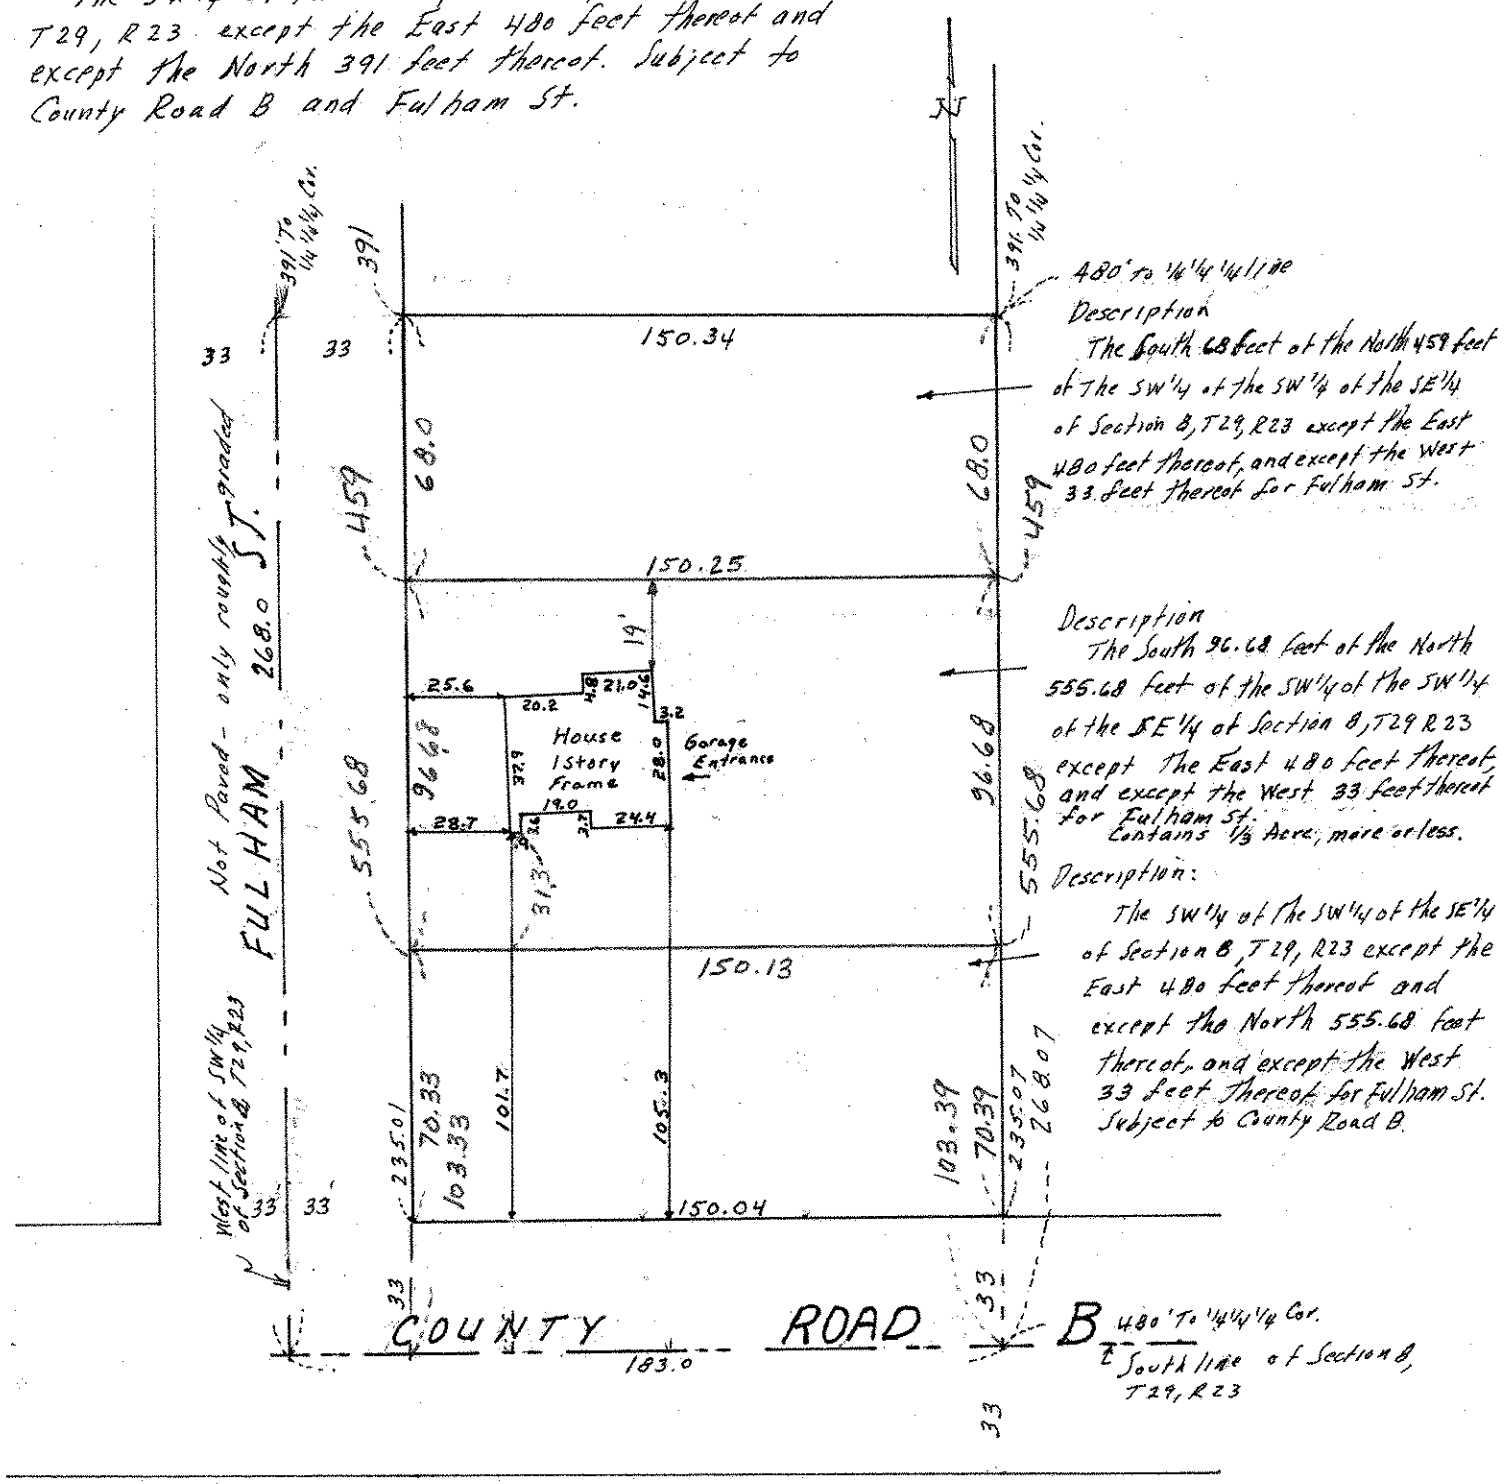
Description:
The SW¼ of the SW¼ of SE¼ of Section 8, T29, R23 except the East 480 feet thereof and except the North 391 feet thereof. Subject to County Road B and Fulham St.