

FROM THE OFFICE OF

CHARLES O. GEORGI COMPANY

2215 West County Road B

Saint Paul, Minnesota 55113

REGISTERED CIVIL ENGINEER AND LAND SURVEYOR



**Certificate
of Survey**

I Hereby Certify that this plat shows a survey made by me of the property described on this plat, and that the corners are correctly placed as shown, and that all locations have been correctly shown.

Surveyed For William D. Ross


Date April, 1970

Scale 1" = 40'

By Charles O. Georgi
REGISTERED LAND SURVEYOR

Description:

Lot 27 Block 2, Rolling Green,
Ramsey County, Minnesota.
and the southerly 1/2 of the adjoining vacated alley.

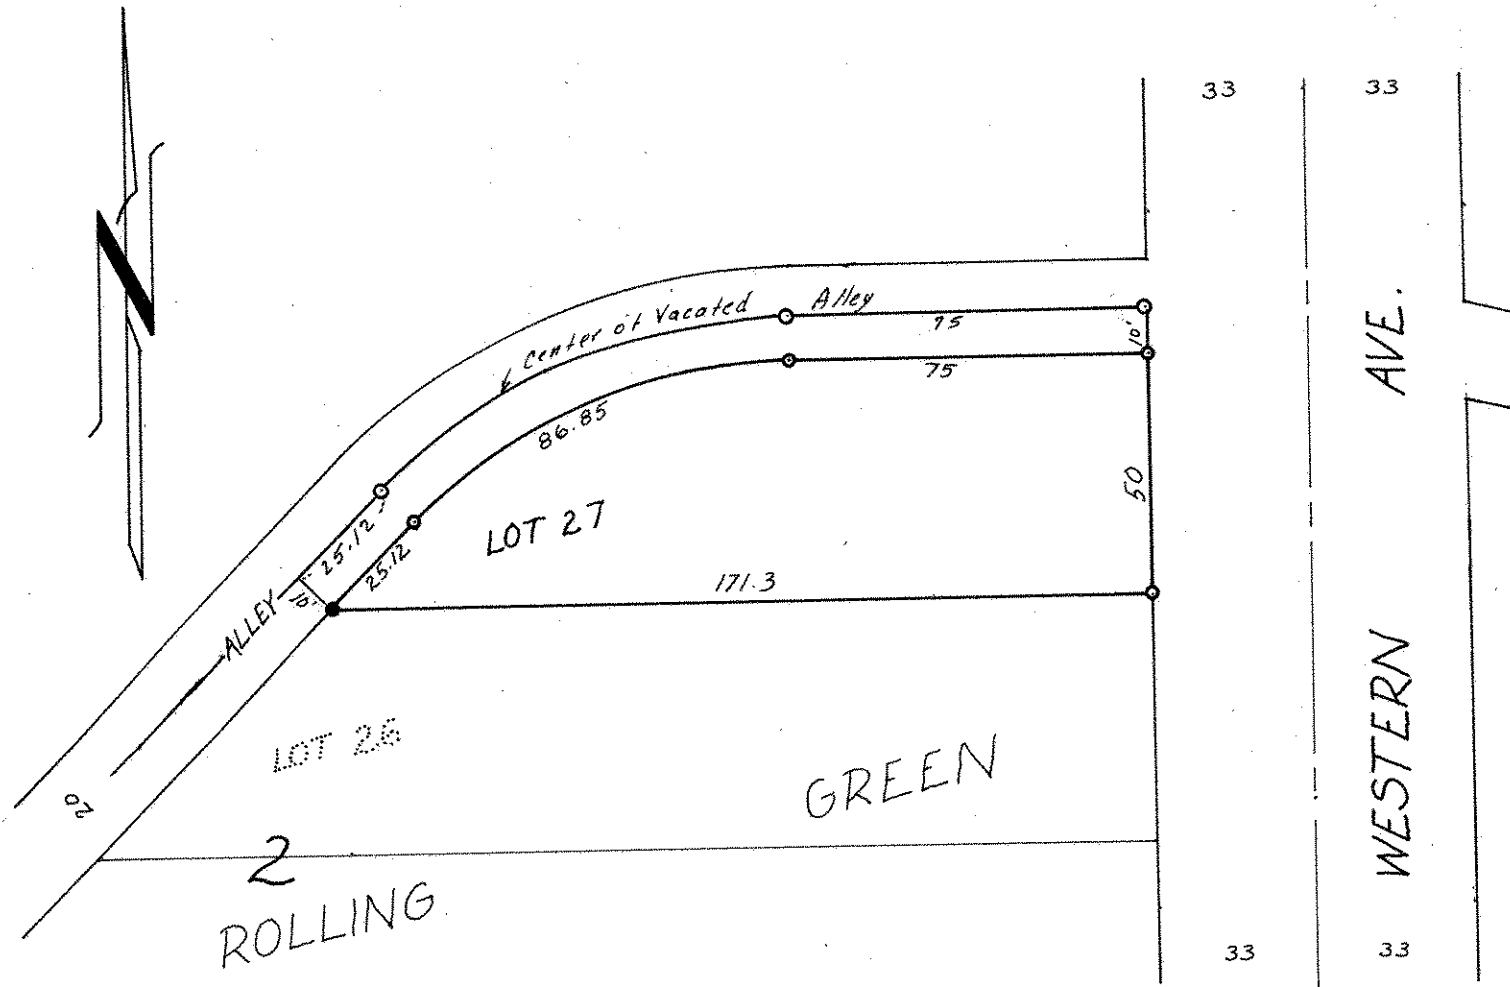

- Denotes Iron Pipe Monument
- Denotes Iron Pipe Monument found in place