

**FROM THE OFFICE OF**

# **CHARLES O. GEORGI COMPANY**

2215 West County Road B

**Saint Paul, Minnesota 55113**

REGISTERED CIVIL ENGINEER AND LAND SURVEYOR

# Certificate of Survey

*I Hereby Certify that this plat shows a survey made by me of the property described on this plat, and that the corners are correctly placed as shown, and that all locations have been correctly shown.*

Surveyed For George Railings

Date November 1976


*Dans* 1' = 60'

By ..... *Charles D. George* .....  
REGISTERED LAND SURVEYOR

**Description:**

That part of the NW $\frac{1}{4}$  of the SW $\frac{1}{4}$  of Section 2, T29N, R23W, described as follows: Beginning at a point 836.03 South of the NE corner of the West  $\frac{1}{2}$  of the West  $\frac{1}{2}$  of the SW $\frac{1}{4}$  of said Section 2; thence south 83.51 Feet; thence East parallel to the East and West  $\frac{1}{4}$  line of said Section 2 a distance of 521.57 Feet; thence North 83.51 Feet to a point 136.3 Feet West and 836.03 Feet South of the NE corner of the West  $\frac{1}{2}$  of the SW $\frac{1}{4}$  of said Section 2; thence west to the point of beginning; Except the East 346.5 thereof, and except the West 161.57 Feet thereof.

Ramsey County, Minn.

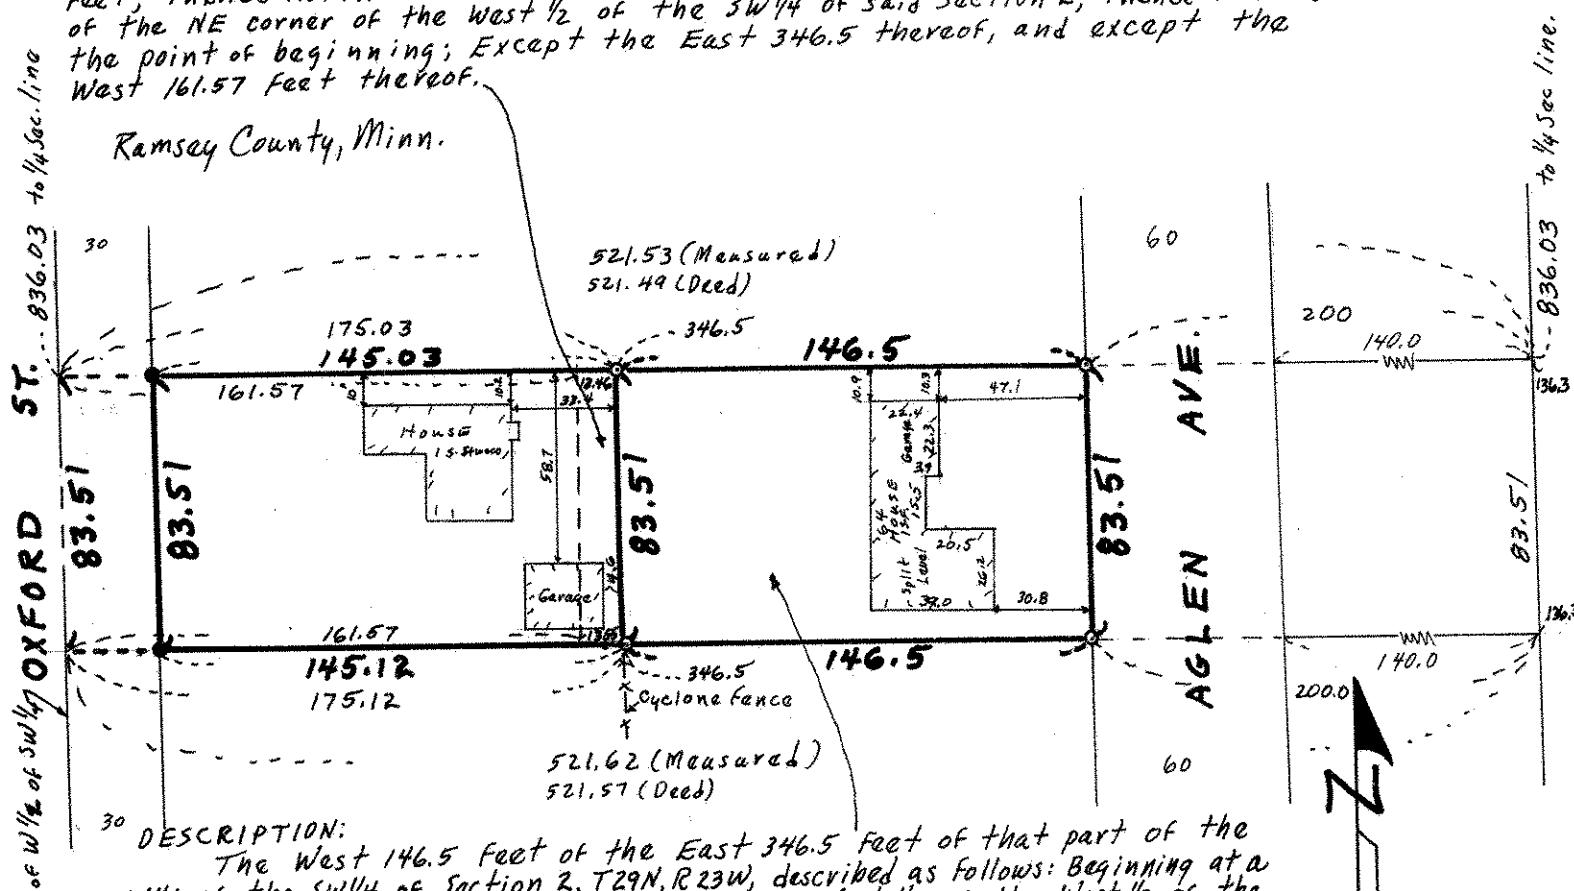

DESCRIPTION:

<sup>30</sup> DESCRIPTION:  
The West 146.5 Feet of the East 346.5 Feet of that part of the NW $\frac{1}{4}$  of the SW $\frac{1}{4}$  of Section 2, T29N, R23W, described as follows: Beginning at a point 836.03 South of the NE corner of the West  $\frac{1}{2}$  of the West  $\frac{1}{2}$  of the SW $\frac{1}{4}$  of said Section 2; thence South 83.51 feet; thence East parallel to the East and West  $\frac{1}{4}$  line of said Section 2 a distance of 521.57 feet; thence North 83.51 feet to a point 136.3 feet West and 836.03 feet South of the NE corner of the West  $\frac{1}{2}$  of the SW $\frac{1}{4}$  of said Section 2; thence West to the point of beginning.

Ramsey County, Minnesota

- Denotes Iron Monument
  - Denotes Iron Found in place