SE 11 2923

FROM THE OFFICE OF

CHARLES O. GEORGI COMPANY

2215 West County Road B — Saint Paul 8, Minnesota

REGISTERED CIVIL ENGINEER AND LAND SURVEYOR

Certificate of Survey

I Hereby Certify that this plat shows a ~~building~~ Drainage location survey made by me on the property described on this plat, and that all locations, have been correctly shown.

Date July 2, 1963

~~Description~~: REINHARDT ADDITION *Scale 1"* = 200 By C. O. Georgi

REGISTERED LAND SURVEYOR

Drainage Study
Note that a ditch with a grade of over 0.3% will drain entire area to 18" Conc. Culvert under B2 and Dale, and then to the North along existing county ditch. Grades show good drainage is possible to South also.
( ) denotes proposed grade.

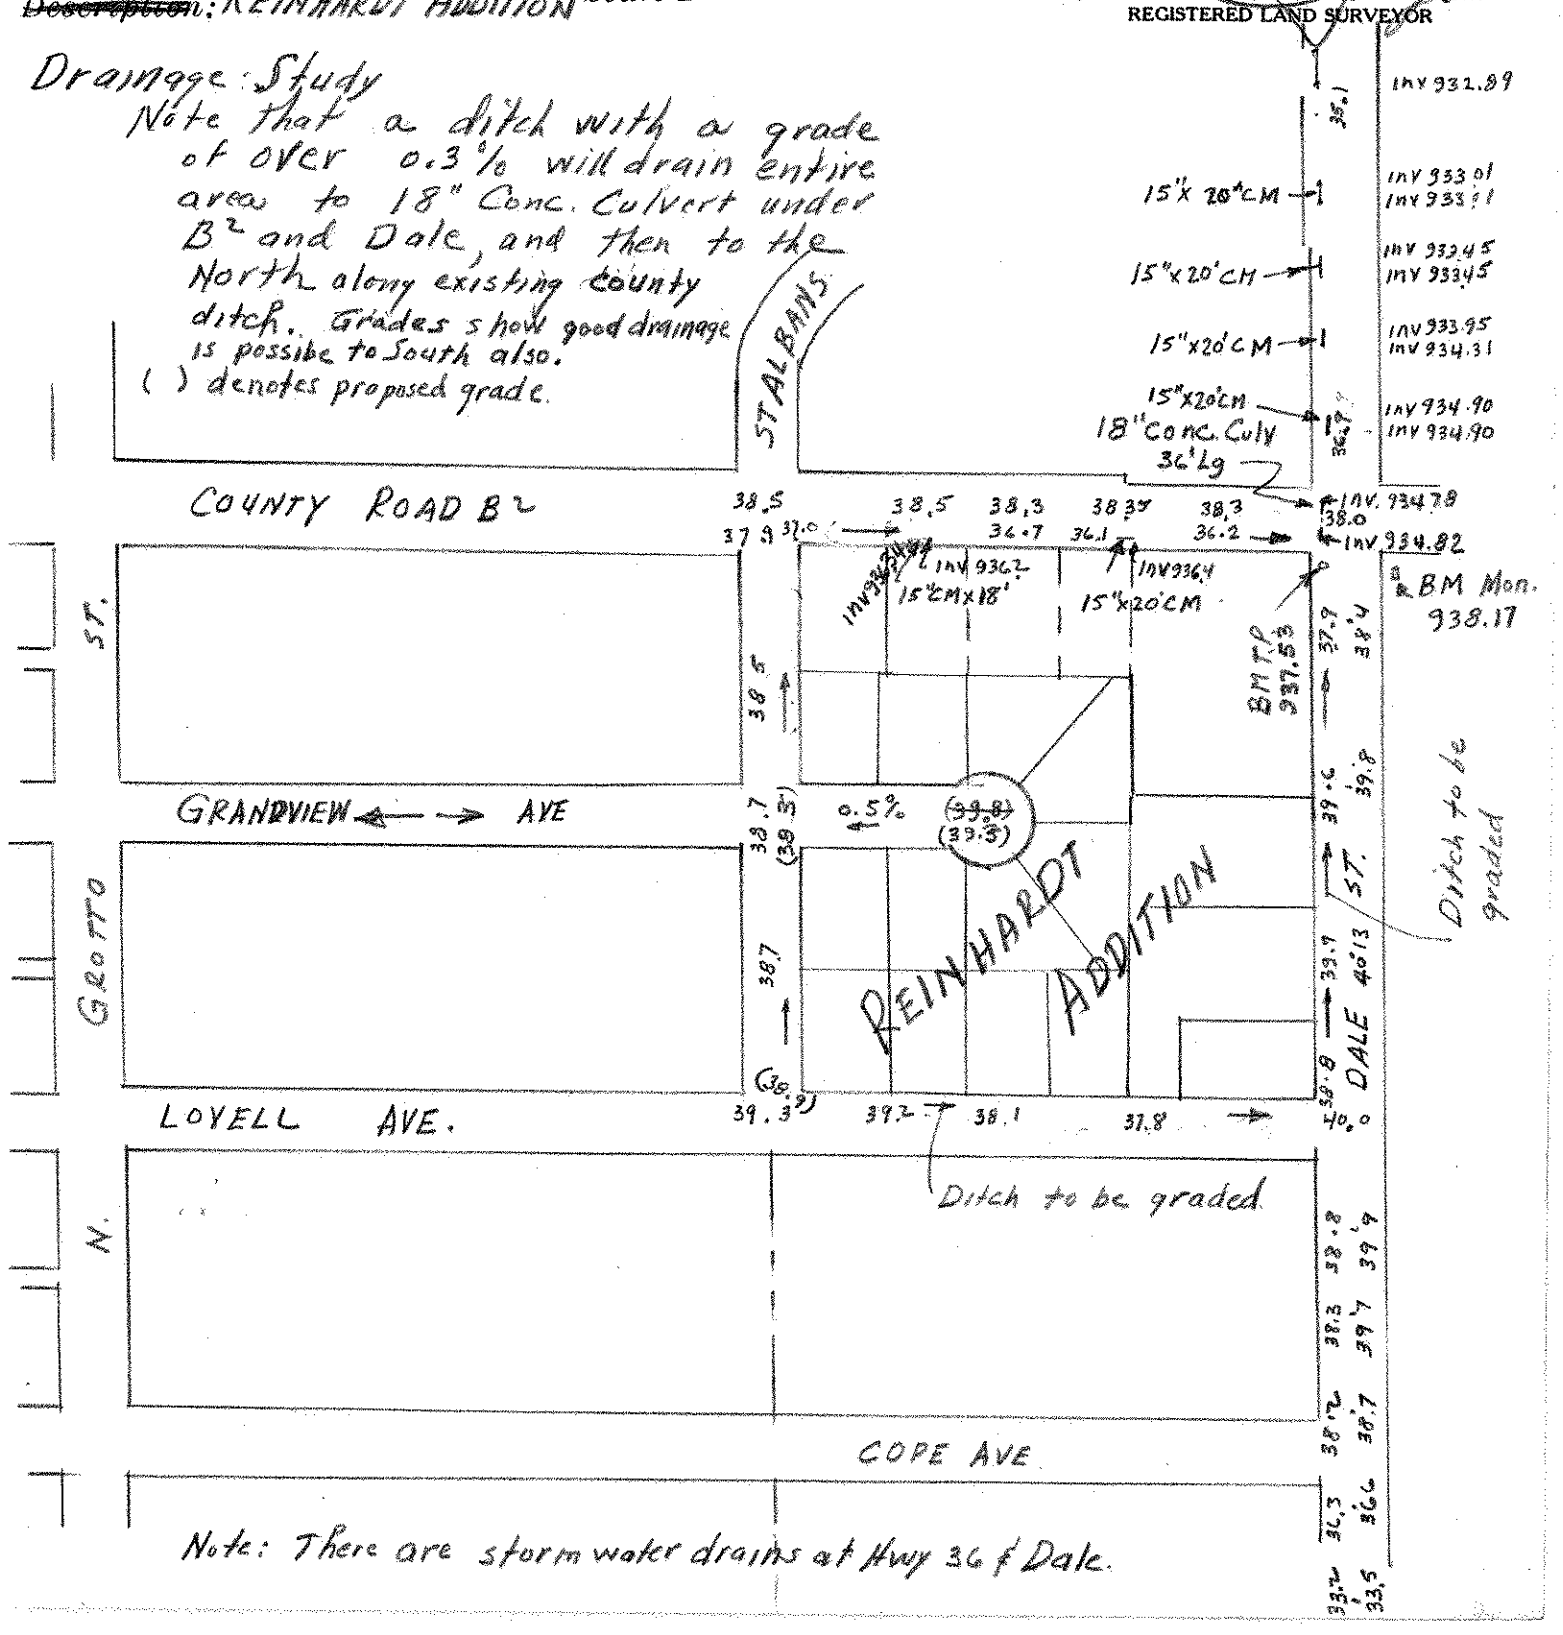

Note: There are storm water drains at Hwy 36 & Dale.