NE 3 29 23

Certificate of Survey

From the office of

GEORGI- SCHMIDT & ASSOC. INC.

3092 No. Lexington Ave., Roseville, Mn. 55113

LAND SURVEYING

483-4408

I Hereby Certify that this plat shows a survey made by me of the property described on this plat, and that the corners are correctly placed as shown,

Job Number: 1207

Surveyed For Belair Builders Inc.

Date JULY 19, 1982

Scale 1" = 40'

By Donald W. Schmidt
REGISTERED LAND SURVEYOR
#10459

Description:
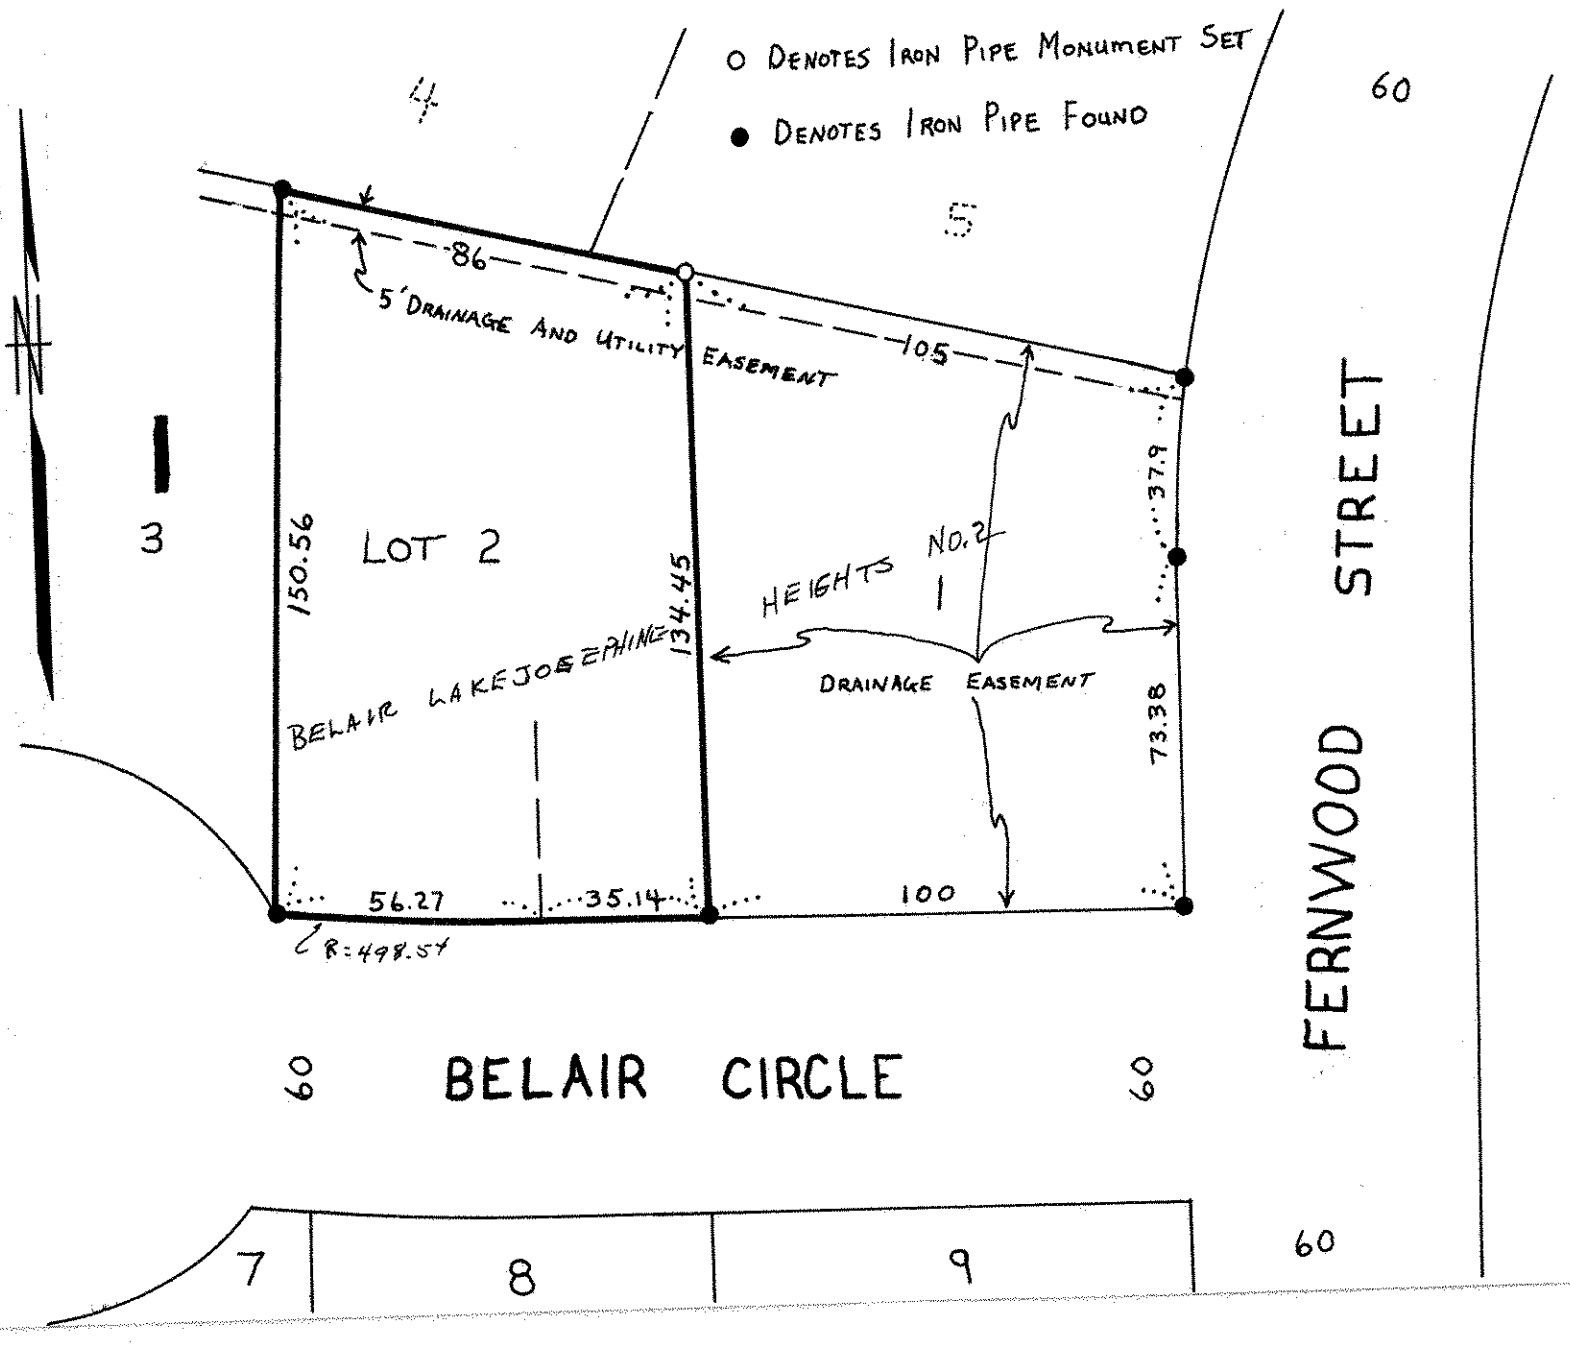
Lot 2, Block 1, Belair Lake Josephine Heights No. 2
Ramsey County, Minnesota