

Certificate
of Survey

From the office of
GEORGI-SCHMIDT & ASSOC. INC.

3092 No. Lexington Ave., Roseville, Mn. 55113

LAND SURVEYING

483-4408

I Hereby Certify that this plat shows a survey made by me of the property described on this plat, and that the corners are correctly placed as shown.

Job Number: 1669

Surveyed For Don White


Date September 5, 1984

Scale 1" = 30'

By _____
REGISTERED LAND SURVEYOR

Description:

Lot 1,
Block 1,
Hedlund Southview,
Ramsey County, Minn.

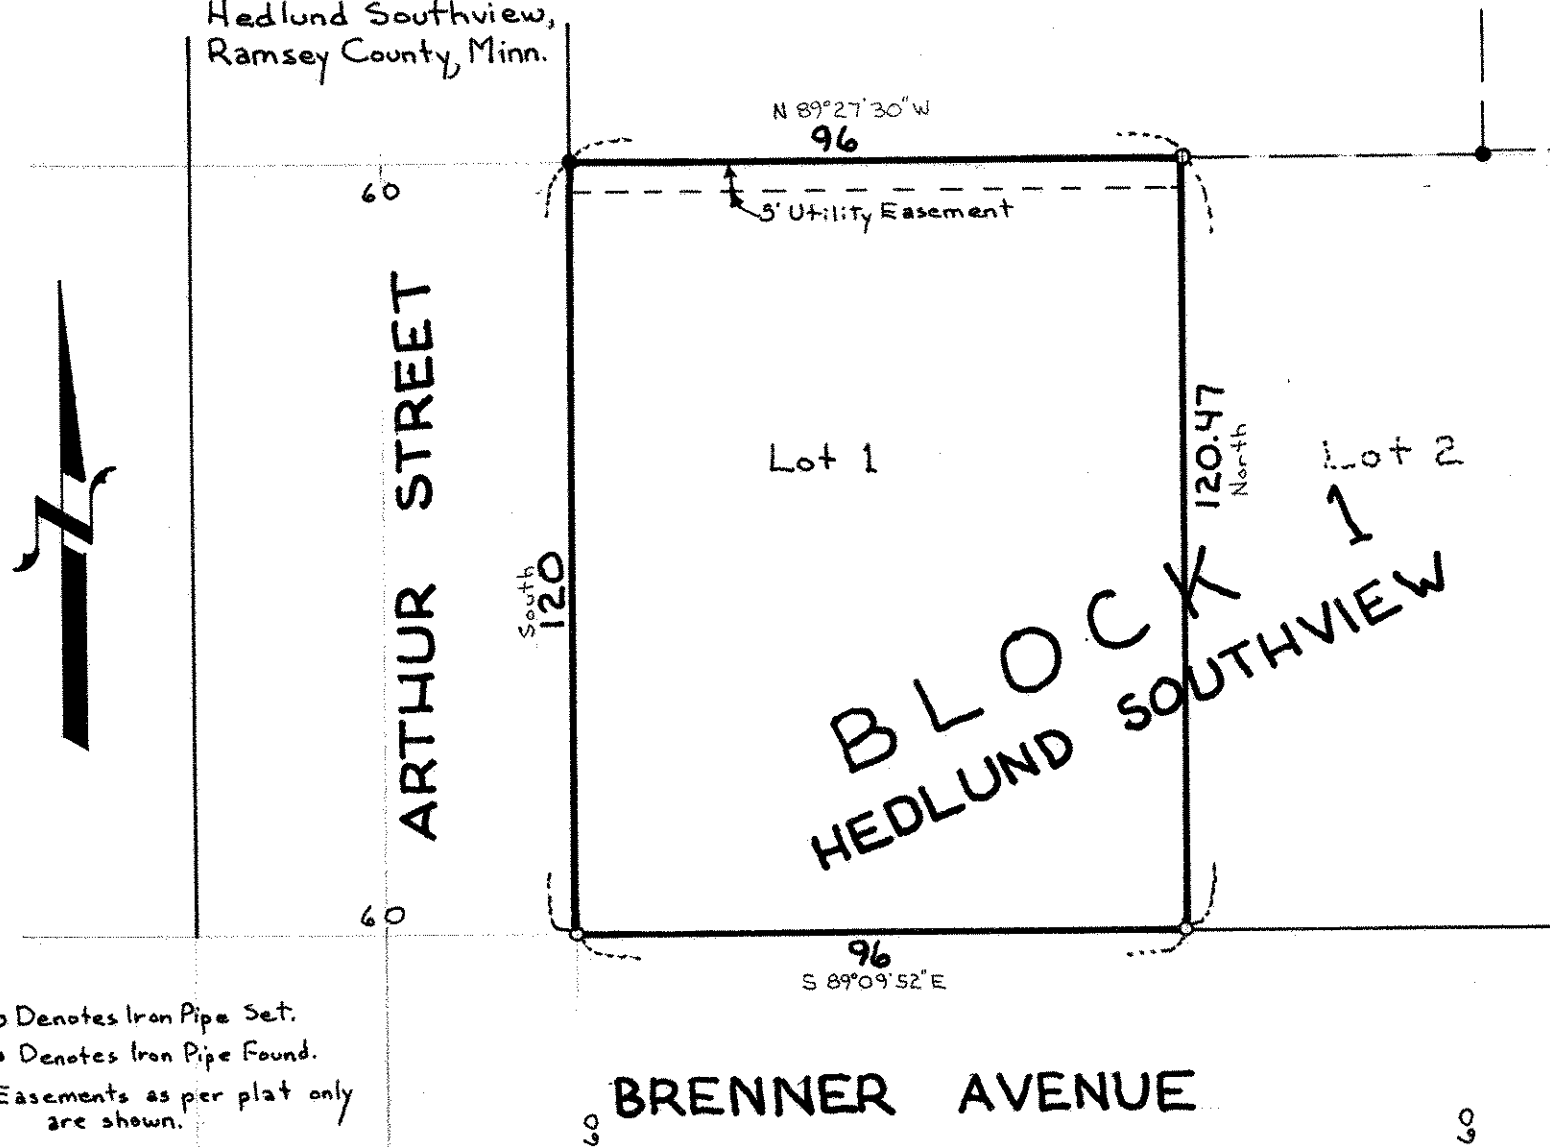

o Denotes Iron Pipe Set.
• Denotes Iron Pipe Found.
Easements as per plat only
are shown.