## FROM THE OFFICE OF

## Certificate

## **CHARLES O. GEORGI COMPANY**

2215 West County Road B

Saint Paul, Minnesota 55113

REGISTERED CIVIL ENGINEER AND LAND SURVEYOR

I Hereby Certify that this plat shows a survey made by me of the property described on this plat, and that the corners are correctly placed as shown, and that all locations have been correctly shown.

Surveyed For Ernie Whitmon

Date July 1975


## Description:

Lot 21. Block 6,

Hamline Syndicate Addition No. 3

Ramsey County,

Minnesota

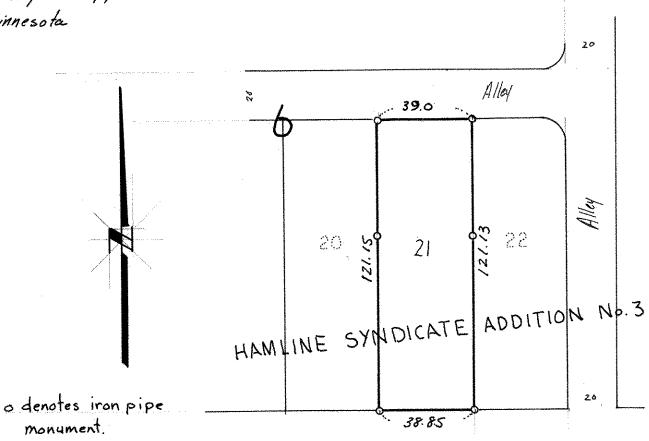

AVE. CHARLES