

Certificate of Survey

From the office of *NW 1 29 23*
GEORGI-SCHMIDT & ASSOC. INC.
 3092 No. Lexington Ave., Roseville, Mn. 55113
 LAND SURVEYING
 483-4408

I Hereby Certify that this plat shows a survey made by me of the property described on this plat, ~~and that the corners are correctly placed as shown~~, that this survey, plan or report was prepared by me, or under my direct supervision; and that I am a duly registered Land Surveyor under the Laws of the State of Minnesota.

Job Number: 3817

Surveyed For Ted Wong, Jr.


Date 12/16/88 - 3/29/89 corners placed

Scale 1" = 40'

By _____
 REGISTERED LAND SURVEYOR
 Mn. Registration No. 10459

DESCRIPTION:

Lot 1, Block 2, Owasso Shores Addition
 Ramsey County, MN.

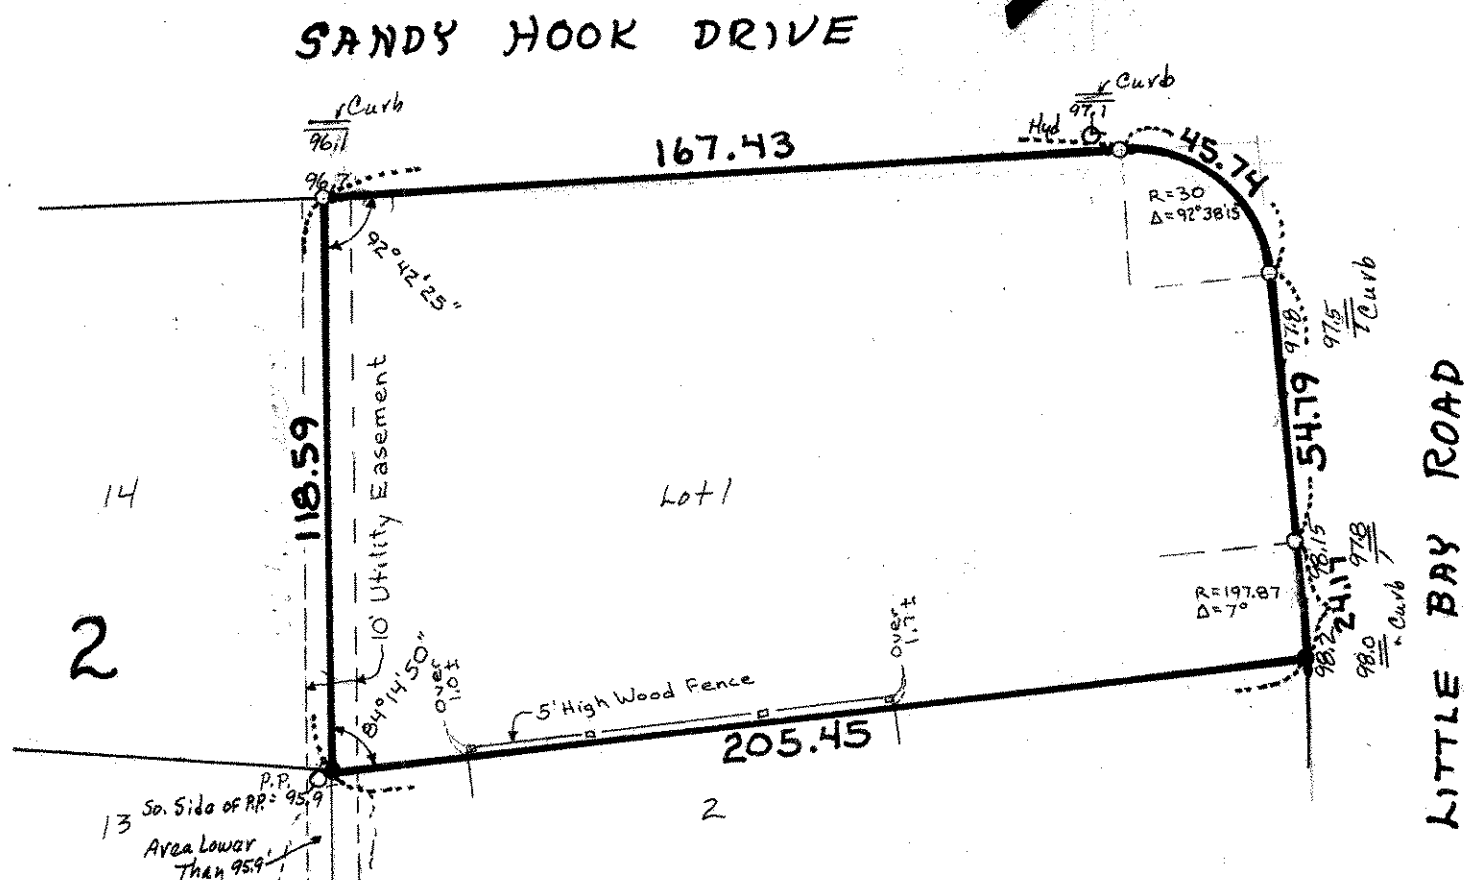

B.M. = 100.0 (Assumed) - Top of nut on Hydrant SW Corner Sandy Hook Drive & Little Bay Rd.

- ⊙ Hyd Denotes Fire Hydrant
- ⊙ P.P. Denotes Power Pole
- Denotes Iron Pipe Found
- Denotes Iron Pipe Set