

FROM THE OFFICE OF

**CHARLES O. GEORGI COMPANY**

2215 West County Road B

Saint Paul, Minnesota 55113

REGISTERED CIVIL ENGINEER AND LAND SURVEYOR



**Certificate  
of Survey**

I Hereby Certify that this plat shows a survey made by me of the property described on this plat, and that the corners are correctly placed as shown, and that all locations have been correctly shown.

Surveyed For J.R. Wright

Date Aug. 1970

Scale 1" = 40'

By Charles O. Georgi  
REGISTERED LAND SURVEYOR


**Description:**

The East 67.46 feet of lot 1,  
Block 2,  
Auditors Subdivision No.50,  
St. Paul, Ramsey County, Minnesota.



80 HUBBARD AVE.

80

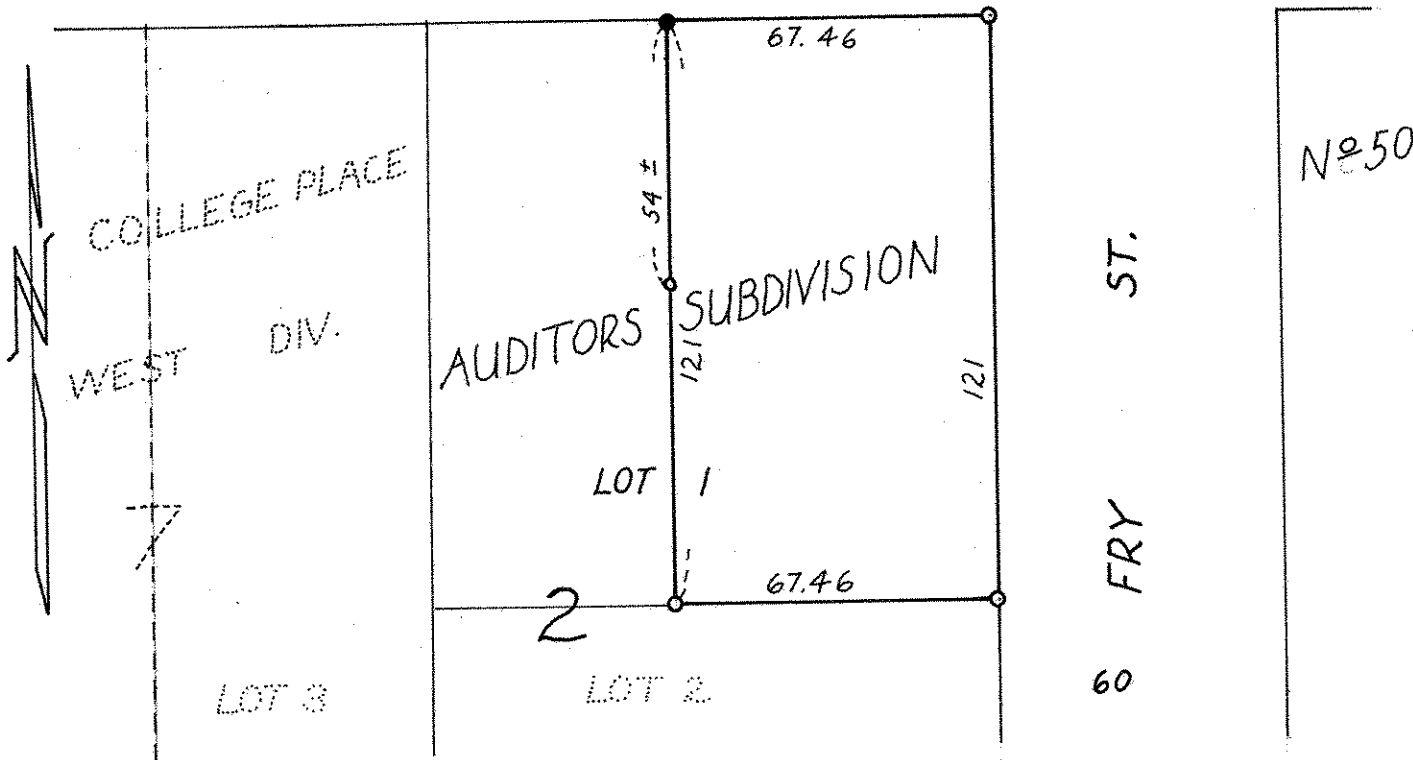

- Denotes Iron Monument
- Denotes Iron Monument found in place