Certificate of Survey

Job Number: 383

From the office of

GEORGI- SCHMIDT & ASSOC. INC.

3092 No. Lexington Ave., Roseville, Mn. 55113 LAND SURVEYING 483-4408

I Hereby Certify that this plat shows a survey made by me of the property described on this plat, and that the corners are correctly placed as shown, and that all locations have been correctly shown.

Surveyed For Housing Authority


Date June 28, 1979


Scale 1" = 40'

By Omalo W. Schmielt

Description:

Lot 14, Block 1, Central Village Addition No. 2, Ramsey County, Minnesota.

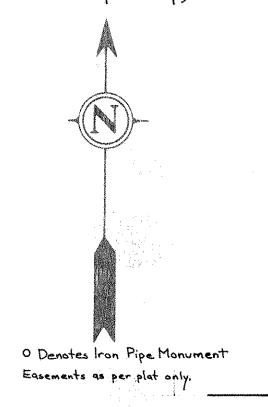

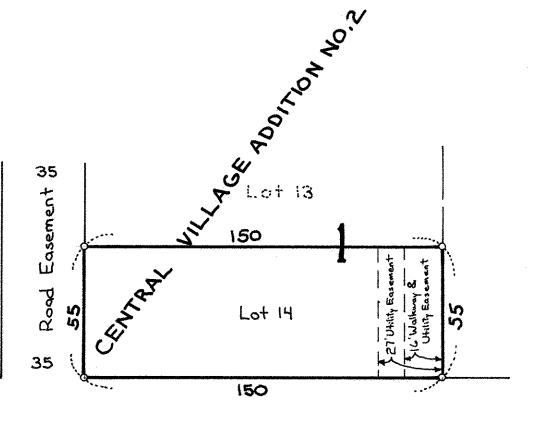

CENTRAL AVENUE

9

