

LOT 8 BLOCK 4

LYMAN D. BAIRD'S ADD.


John B. Irvine, Surveyor.

July 5th 1921.

Scale 10 ft. per inch.

N

LOT 6,

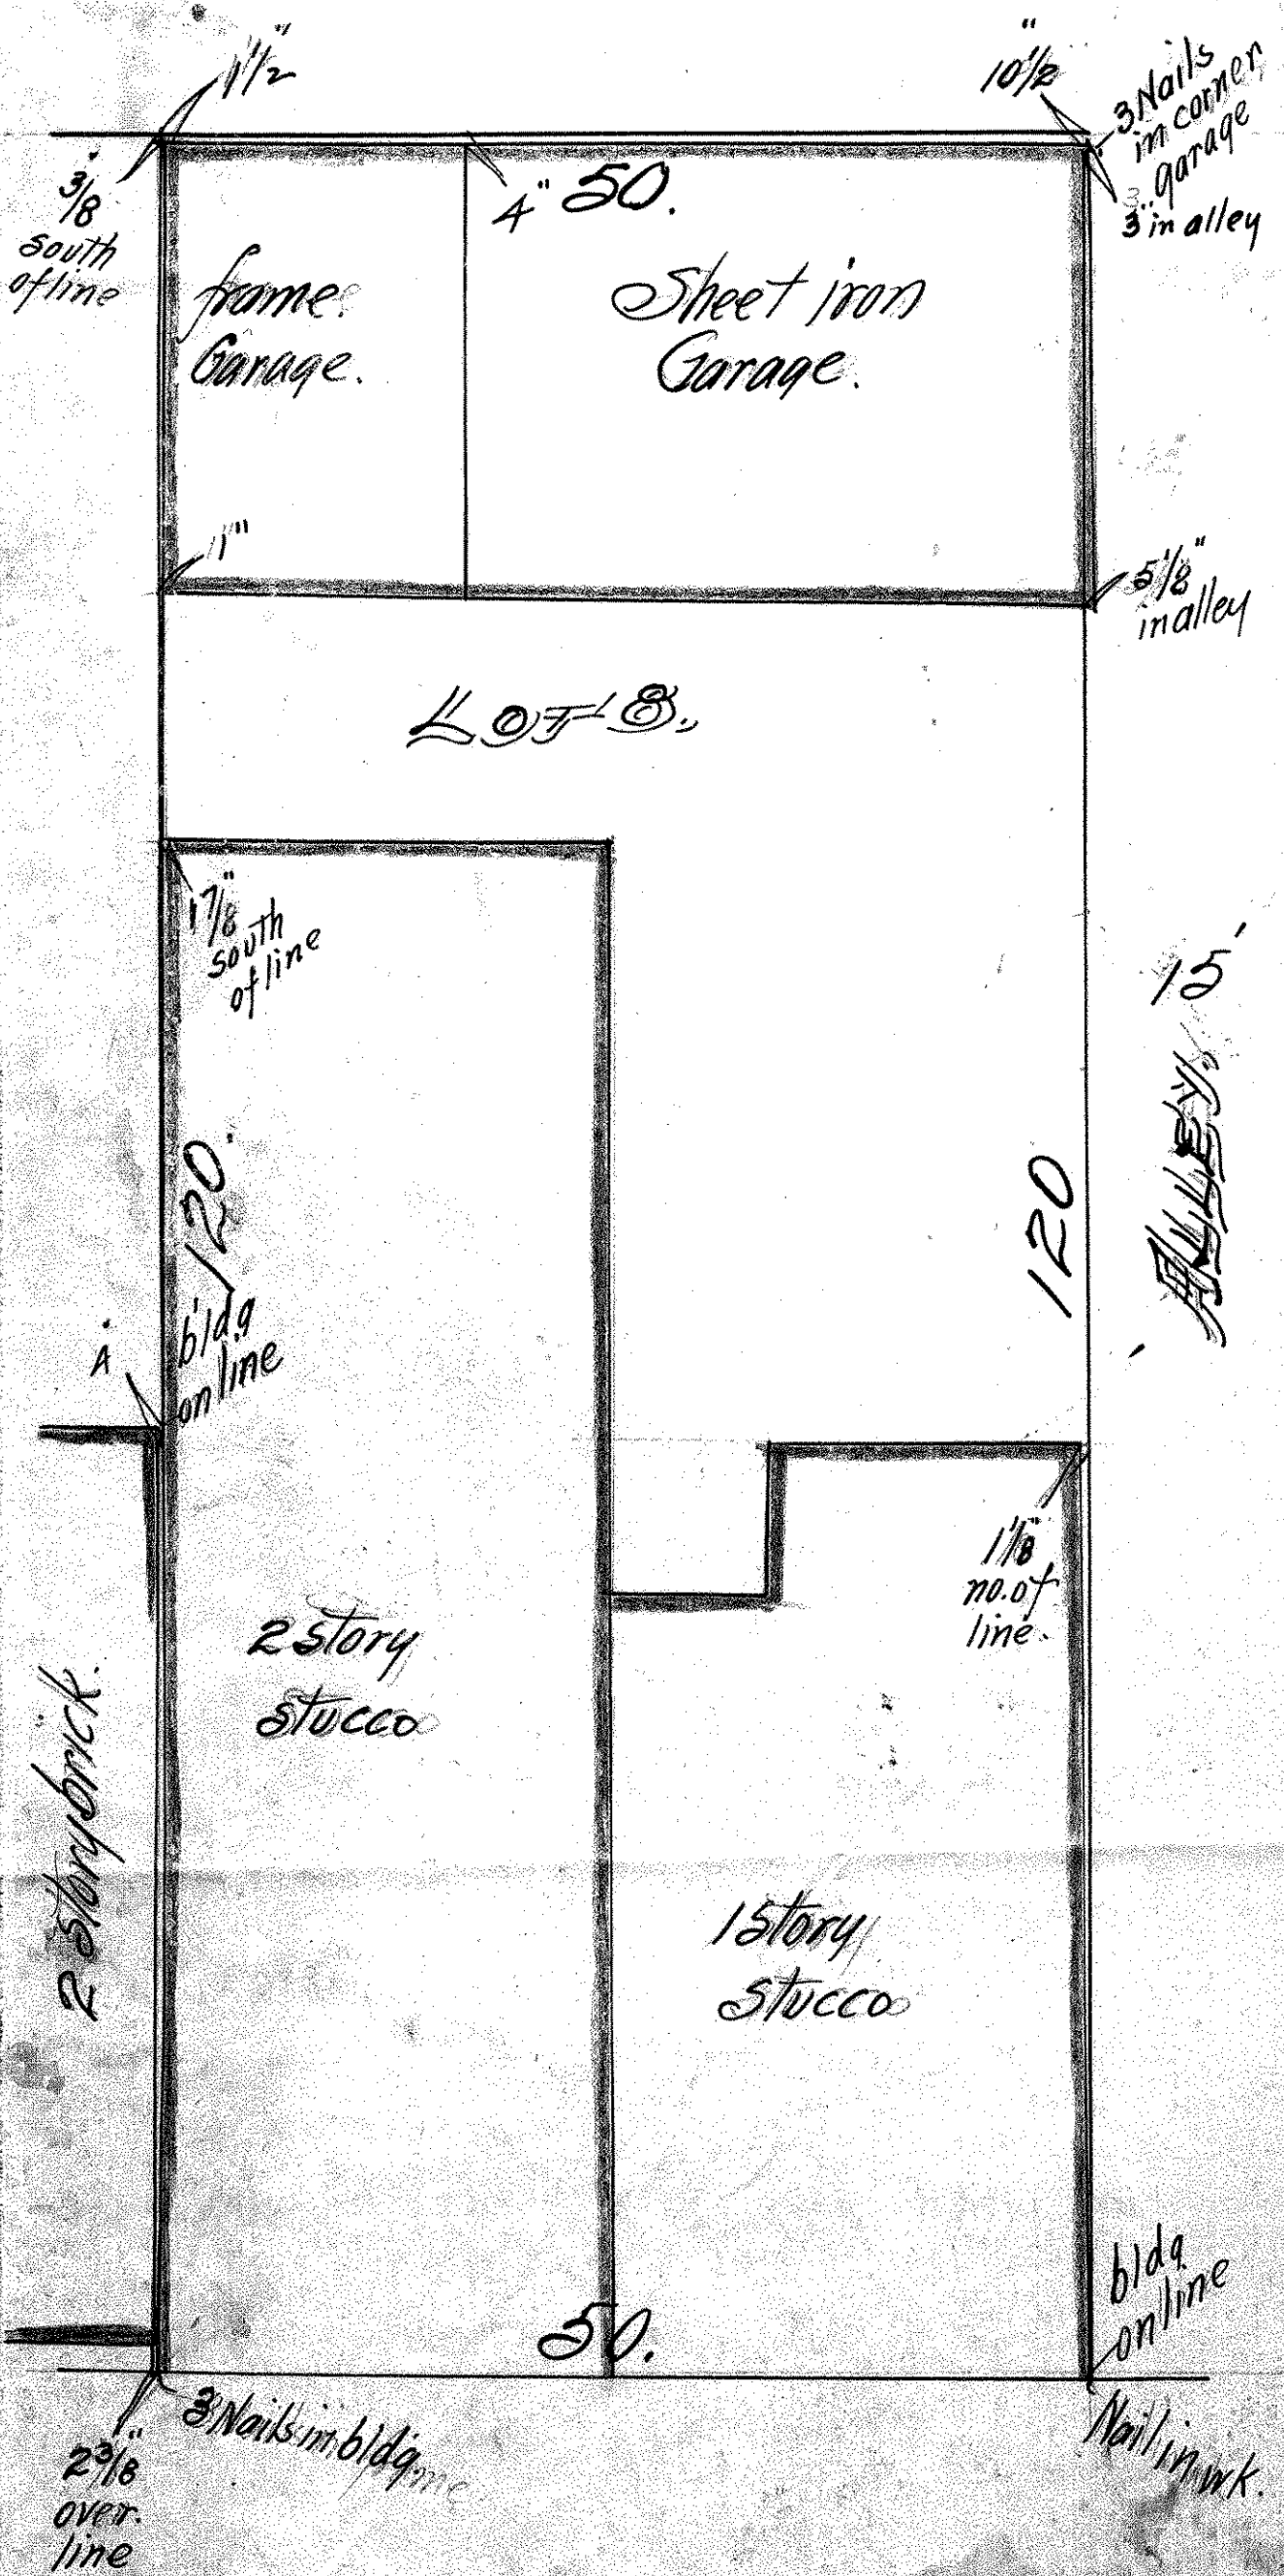

SNELLING AVE.