


LOT 14 BLOCK 2  
BAILEY'S ADD.  
scale 20 feet pr inch  
surveyed June 23<sup>rd</sup> 1902

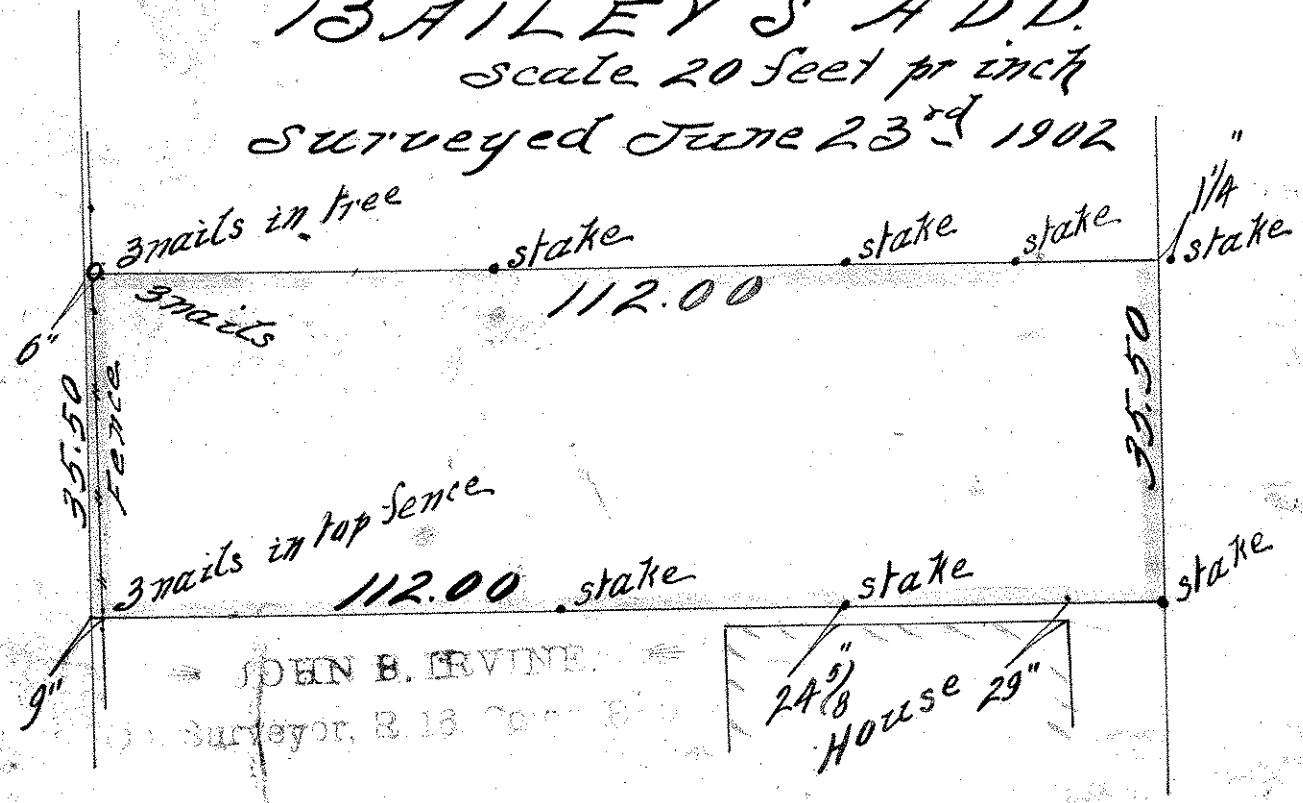

LOUIS ST.

1041132