


LOT 24 BLOCK 3.
BAKER'S ADD.

JOHN B. IRVINE, SURVEYOR.
408 GLOBE BLDG.
ST. PAUL, MINN.
FEB. 15-1912

SCALE 20 ft. per inch.

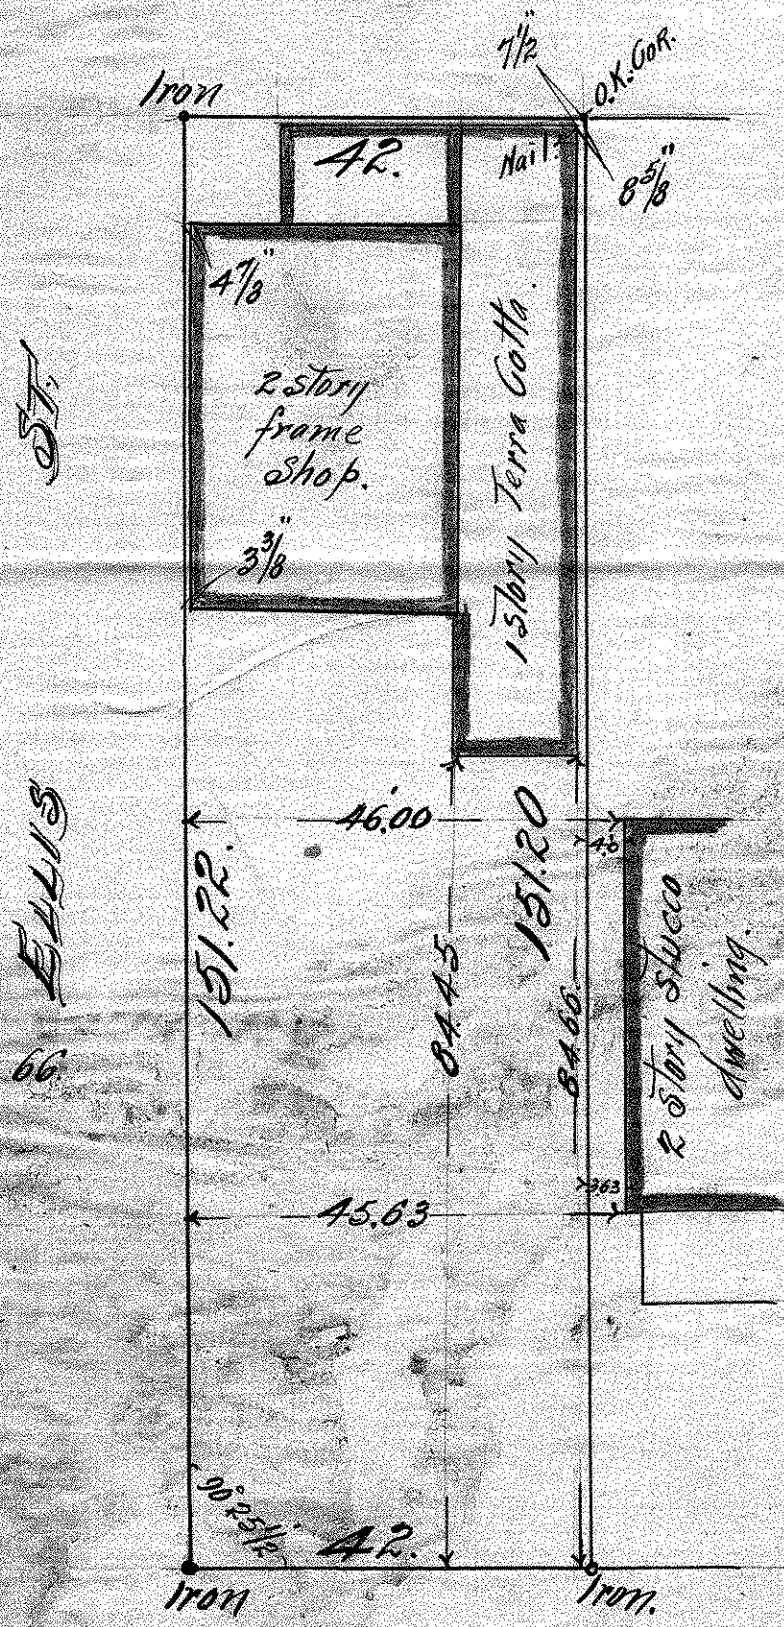

CURFEW AVE. 66.