

5	20	1										20
6	40.06	"	"	"	"	"	"	40.06	40.06	34.73		
7	123.5	12	13	14	15	16	17	18	19	20	123.3	
8		"	"	"	"	"	"	"	"	"	"	
9		"	"	"	"	"	"	"	"	"	"	
10		40.06	40.06	40.06	40.06	40.06	40.06	40.06	40.06	34.46	old Iron.	
98.59												

60' STINSON ST. 66'


33	22.96	98.60	40.06	40.06	40.06	40.06	40.06	40.06	40.06	40.06	26.71	26.71	26.71	34.46
1	25	1	126.35	10	9	8	7	6	5	4	3	2	1	126.35
2	3	"		"	"	"	"	"	"	"	"	"	"	"
3	4	"		"	"	"	"	"	"	"	"	"	"	"
4	5	40.05		"	"	"	"	"	"	40.05	26.75	26.70	34.75	
5	6	20	2										20	
6	7	126.35	126.35	"	"	"	"	"	"	"	"	"	"	126.35
7	8		"	"	"	"	"	"	"	"	"	"	"	
8	9		"	"	"	"	"	"	"	"	"	"	"	
9	10		40.05	"	"	"	"	"	"	40.05	26.75	26.70	34.75	
10	25	98.75												

60' BURGUSS 66'

NOTE - POWER POLE IS LOCATED ON S.W. CORNER OF LOT 3 OF BLOCK 2

THIS IS TO CERTIFY THAT THE BANISTER ENGINEERING CO OF ST. PAUL MINN., REGISTERED PROFESSIONAL ENGINEERS, HAVE SURVEYED, AND PLACED IRON MONUMENTS AS SHOWN, THE FOLLOWING PROPERTY --- LOT 18 BLOCK 1 AND A PARCEL DESCRIBED AS THE WEST 1/3 OF LOT 2 & EAST 1/3 OF LOT 3 BLOCK 2 --- ALSO A PARCEL DESCRIBED AS THE WEST 2/3 OF LOT 3 BLOCK 2 --- ALL BEING IN BEIFIELD'S SUB-DIVISION ST. PAUL MINN. IN THE S.E. 1/4 OF SEC 25 T29 R23. June 16, 1936.

BANISTER ENGINEERING CO.
ST. PAUL MINNESOTA HUDSON WISCONSIN

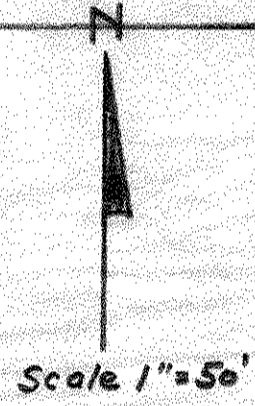

FARRINGTON

GAULTIER

WAYZATA