

Certificate of Survey

From the office of
GEORGI-SCHMIDT & ASSOC. INC.
3092 No. Lexington Ave., Roseville, Mn. 55113
LAND SURVEYING
483-4408

I Hereby Certify that this plat shows a survey made by me of the property described on this plat, and that the corners are correctly placed as shown, and that all locations have been correctly shown.

Job Number: 1552

Surveyed For Craig Bandle

Date 3/1/84

Scale 1" = 50'


By Donald W. Schmidt
REGISTERED LAND SURVEYOR
#10459

Description:

Lot 2, Block 1, Foster Shores
Ramsay County, MN.

I hereby certify that this survey was prepared by me, or under my direct supervision, and that I am a duly Registered Land Surveyor under the laws of the State of Minnesota.

Date _____ Reg. No. _____

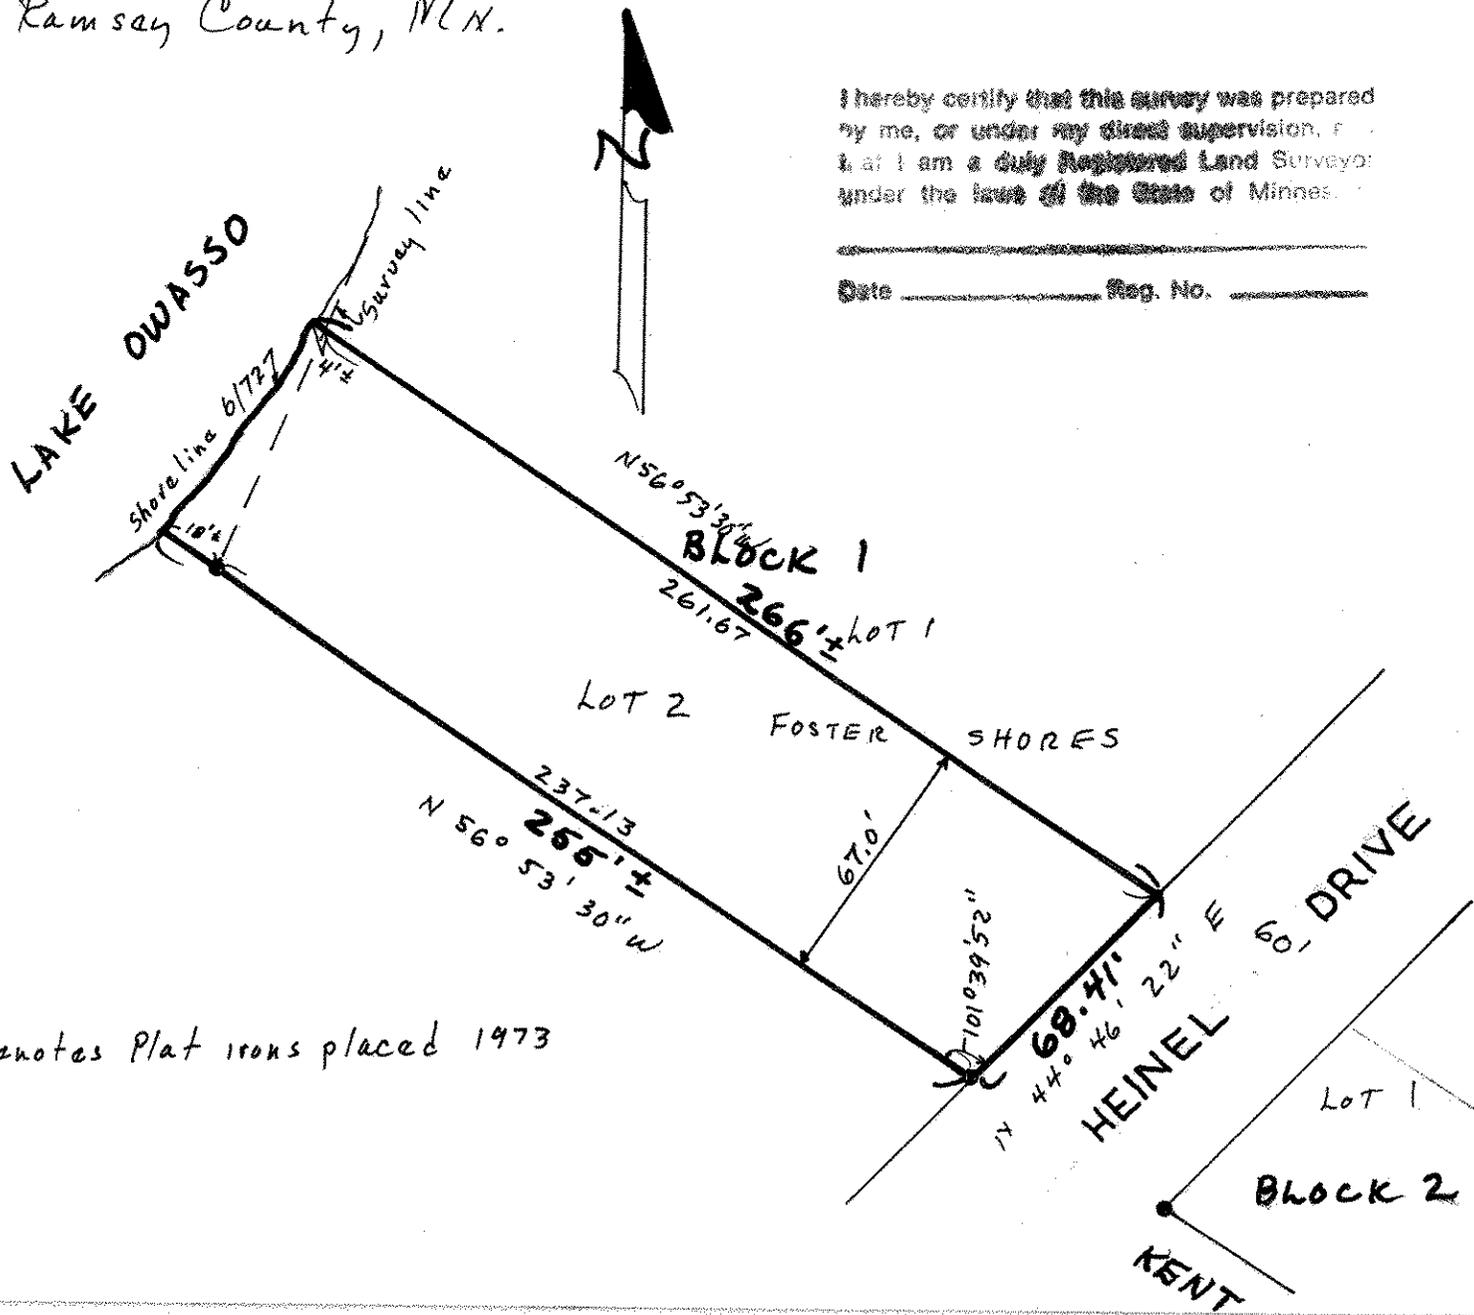

• Denotes Plat irons placed 1973