NW 13 29 23

Certificate of Survey

From the office of

GEORGI- SCHMIDT & ASSOC. INC.

3092 No. Lexington Ave., Roseville, Mn. 55113

LAND SURVEYING

483-4408

I Hereby Certify that this plat shows a survey made by me of the property described on this plat, and that the corners are correctly placed as shown, and that all locations have been correctly shown.

Job Number: 279

Surveyed For Albert F. Bruchner

Date June 1979

Scale 1"=100'

By Donald W. Schmidt
REGISTERED LAND SURVEYOR

Description:

The West 152.61 feet of the East 368.61 feet of the South 210.86 feet of the SW ¼ of the NW ¼ of Section 13, T29N, R23W. Subject to Roselawn.
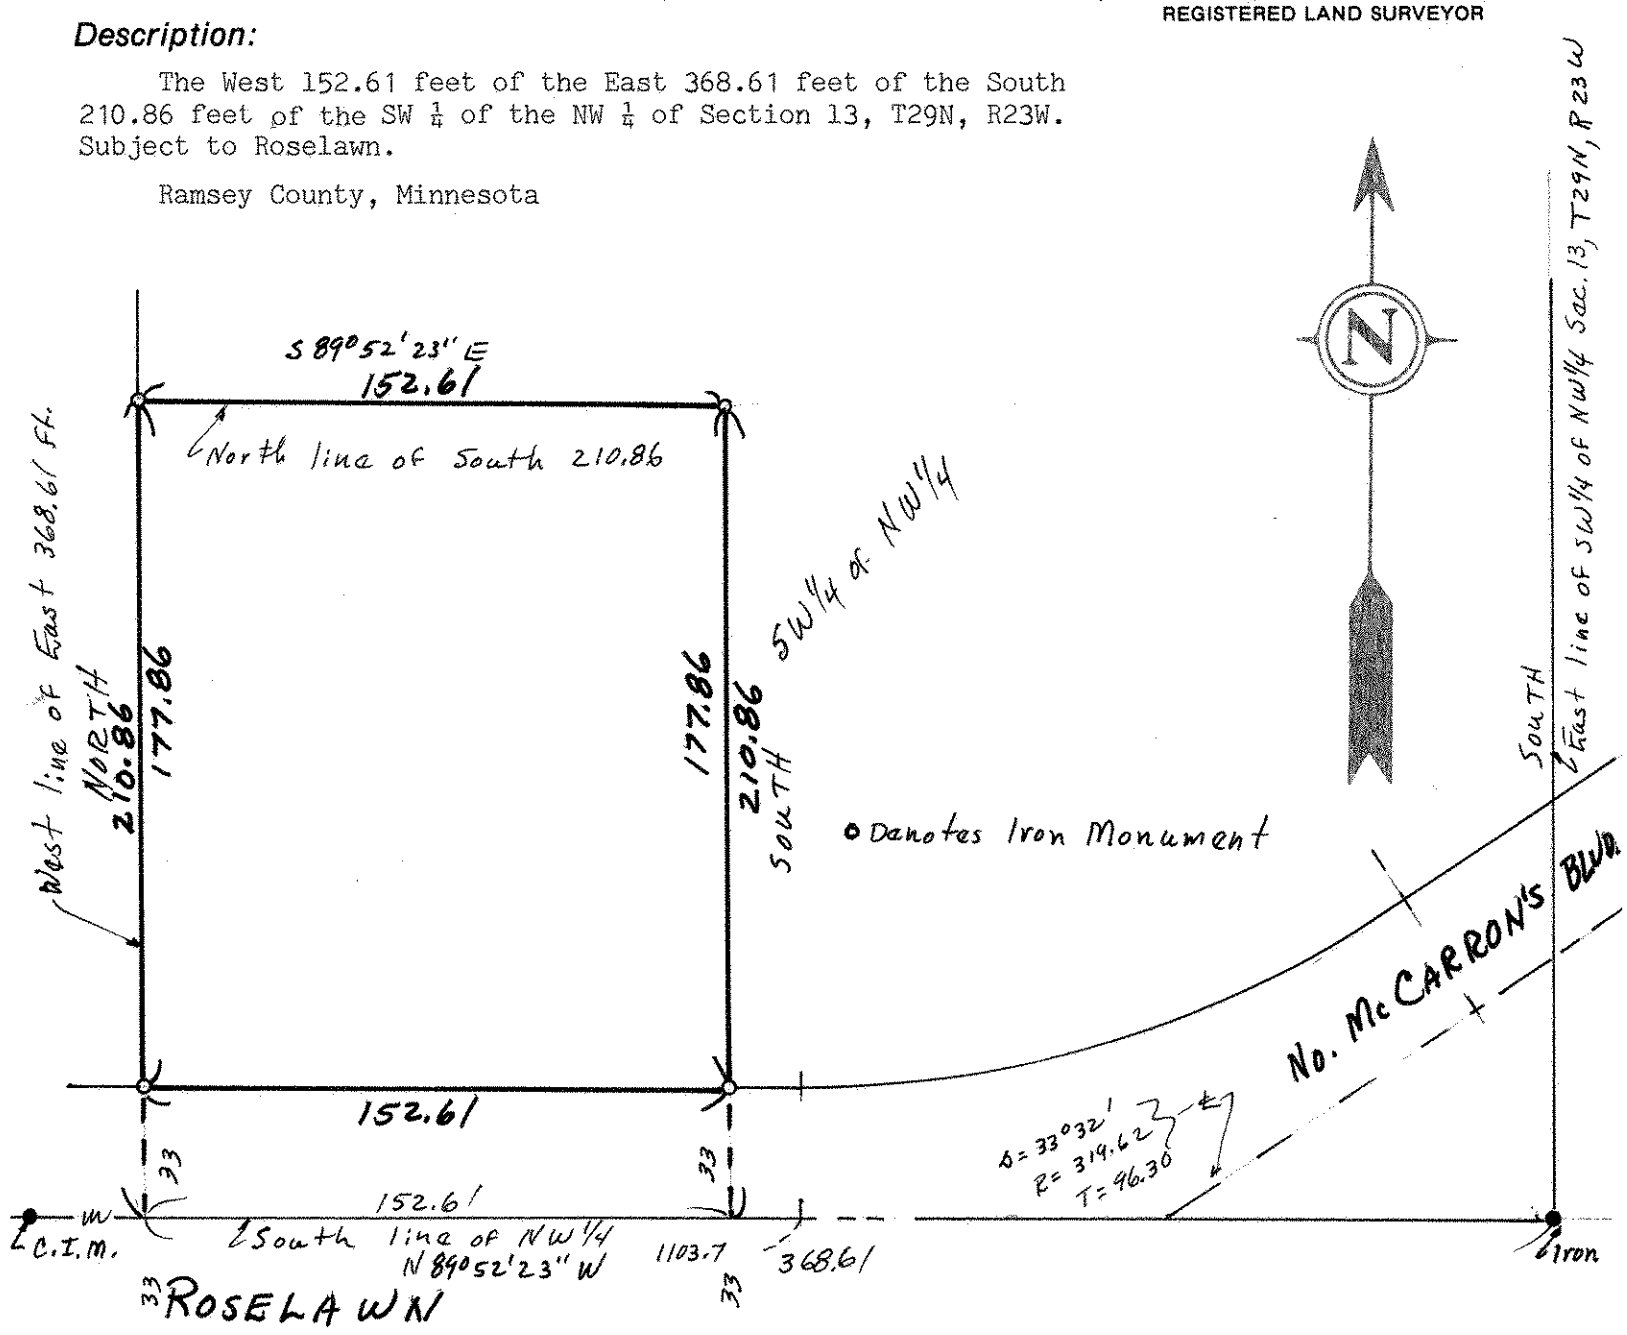
Ramsey County, Minnesota