SW 36 29 23

FROM THE OFFICE OF

CHARLES O. GEORGI COMPANY

2215 West County Road B — Saint Paul, Minnesota 55113

REGISTERED CIVIL ENGINEER AND LAND SURVEYOR

Certificate of Survey

Project No. Minn A-1-1
Parcel No. 52-F
Area 6,998 sq. ft. m.o.l.

I Hereby Certify that **this plat shows a survey made by me of the property described on this plat, and that the corners are correctly placed as shown, and that all locations have been correctly shown.** 5-22-73 Added Block 13 to description

Surveyed For Housing Authority

Date May 1973

Scale 1" = 30'

By Charles O. Georgi
REGISTERED LAND SURVEYOR

Description:

The North 100 feet of Lot 9 except the East 0.59 feet and the North 100 feet of Lot 10 except the West 8.99 feet, Block 13, Mackubin and Marshall's Addition to St. Paul, Ramsey County, Minn.

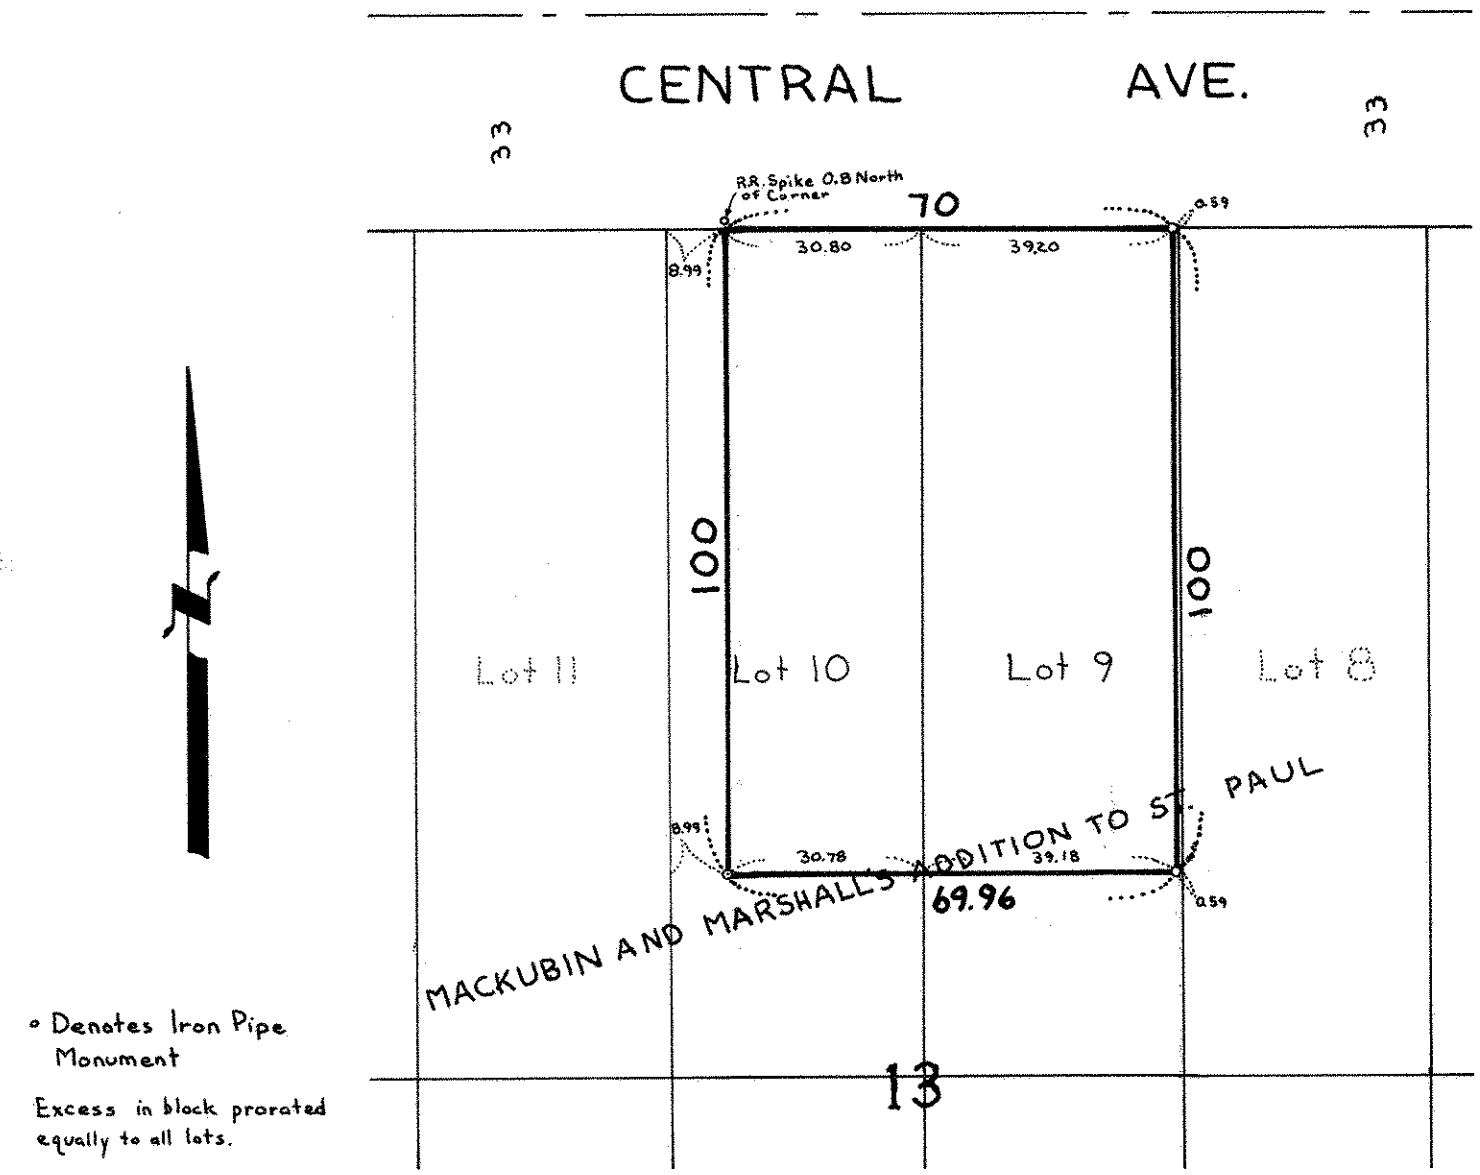

∘ Denotes Iron Pipe Monument

Excess in block prorated equally to all lots.