

NW 36.29.23

FROM THE OFFICE OF

CHARLES O. GEORGI COMPANY

2215 West County Road B

Saint Paul, Minnesota 55113

REGISTERED CIVIL ENGINEER AND LAND SURVEYOR

Certificate of Survey

I Hereby Certify that this plat shows a survey made by me of the property described on this plat, and that the corners are correctly placed as shown, and that all locations have been correctly shown.


Project No. *MINN A-1-1*
Parcel No. *1-A*
Area. *8,335 sq. ft. m.o.l.*

Surveyed For *Housing Authority*
Date *June 1973*
Scale *1"=30'*

By *Charles O. Georgi*
REGISTERED LAND SURVEYOR

Description:

*Lots 9 and 10, Block 16, Smith's Subdivision of
Stinson's Division of the N.W. 1/4 of Section 36, Township 29,
Range 23, Ramsey County, Minnesota.*

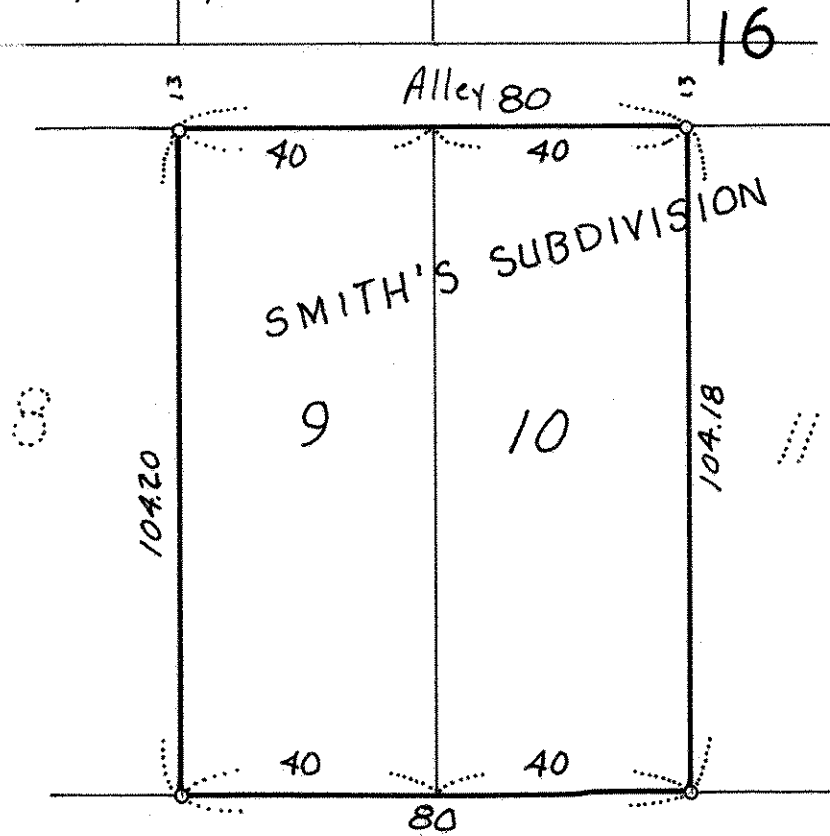

3 UNIVERSITY AVE. 3