

FROM THE OFFICE OF

CHARLES O. GEORGI COMPANY

2215 West County Road B

Saint Paul, Minnesota 55113

REGISTERED CIVIL ENGINEER AND LAND SURVEYOR

Certificate of Survey

I Hereby Certify that this plat shows a survey made by me of the property described on this plat, and that the corners are correctly placed as shown, and that all locations have been correctly shown.

Project No. Minn A-1-1
Parcel No. 56-H
Area: 4,820 sq. ft. m.a.l.

Surveyed For Housing Authority

Date July 1973


Scale 1"=40'

By Charles O. Georgi
REGISTERED LAND SURVEYOR

Description:

Lot 8,
Block 12,
Butterfield Syndicate Addition No. 1,
Ramsey County,
Minnesota.

33 CENTRAL AVE. 33

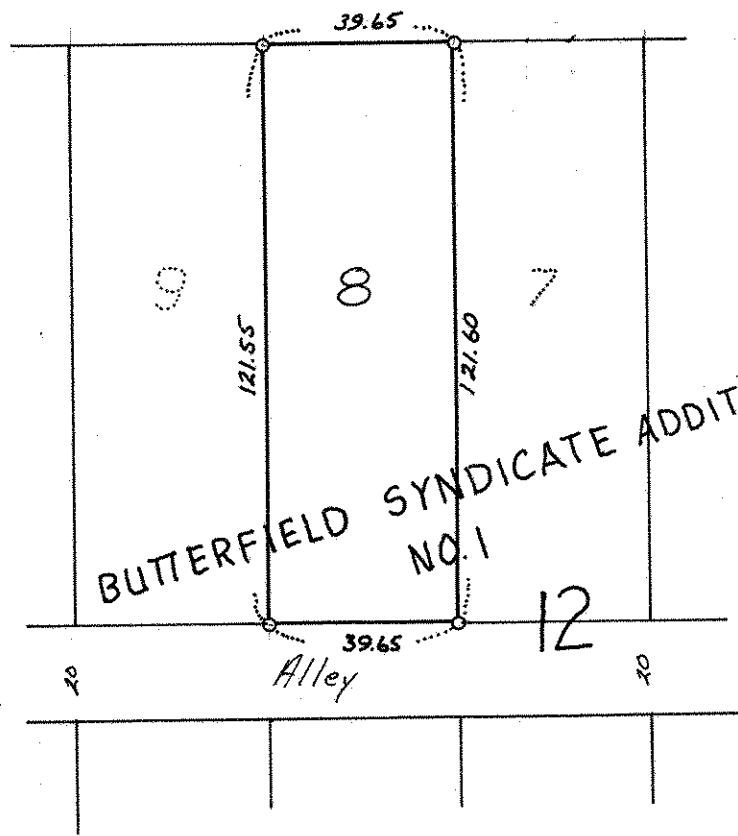

o denotes iron monument.