

FROM THE OFFICE OF

# CHARLES O. GEORGI COMPANY

2215 West County Road B

Saint Paul, Minnesota 55113

REGISTERED CIVIL ENGINEER AND LAND SURVEYOR

## Certificate of Survey

I Hereby Certify that this plat shows a survey made by me of the property described on this plat, and that the corners are correctly placed as shown, and that all locations have been correctly shown.

Project No. Minn A-1-1  
Parcel No. 68-B, C  
Area. 15,930 sq. ft. mo. l.

Surveyed For Housing Authority


Date August 1973

Scale 1" = 40'

By Charles O. Georgi  
REGISTERED LAND SURVEYOR

**Description:**

Lots 6, 7 and 8,  
Block 5,  
Edwin Deans Second Addition,  
Ramsey County,  
Minnesota.

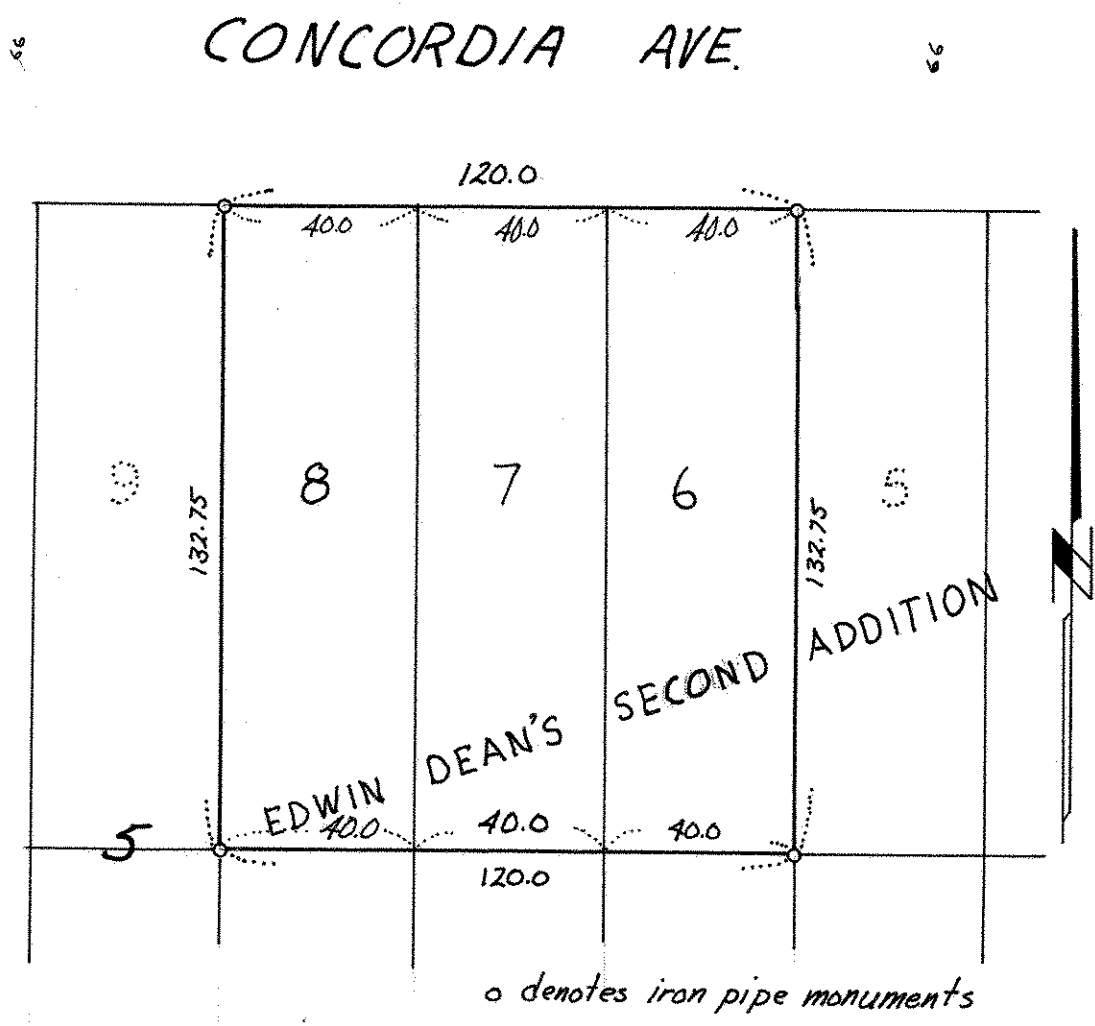

o denotes iron pipe monuments