SE 35 29 23

FROM THE OFFICE OF

CHARLES O. GEORGI COMPANY

2215 West County Road B Saint Paul, Minnesota 55113

REGISTERED CIVIL ENGINEER AND LAND SURVEYOR

Certificate of Survey

Project No. Minn. A-1-1
Parcel No. 69-B
Area: 6620 Sq.Ft., m.o.L.

I Hereby Certify that this plat shows a survey made by me of the property described on this plat, and that the corners are correctly placed as shown, and that all locations have been correctly shown. Redrawn July 1974 add: lot 3

Surveyed For Housing Authority

Date October 1973

Scale 1" = 40'

By Charles O. Georgi
REGISTERED LAND SURVEYOR

Description:

Lots 1 and 2, Block 6, Edwin Deans Second Addition, except the South 50.0 feet thereof, subject to street widening on Concordia Ave.
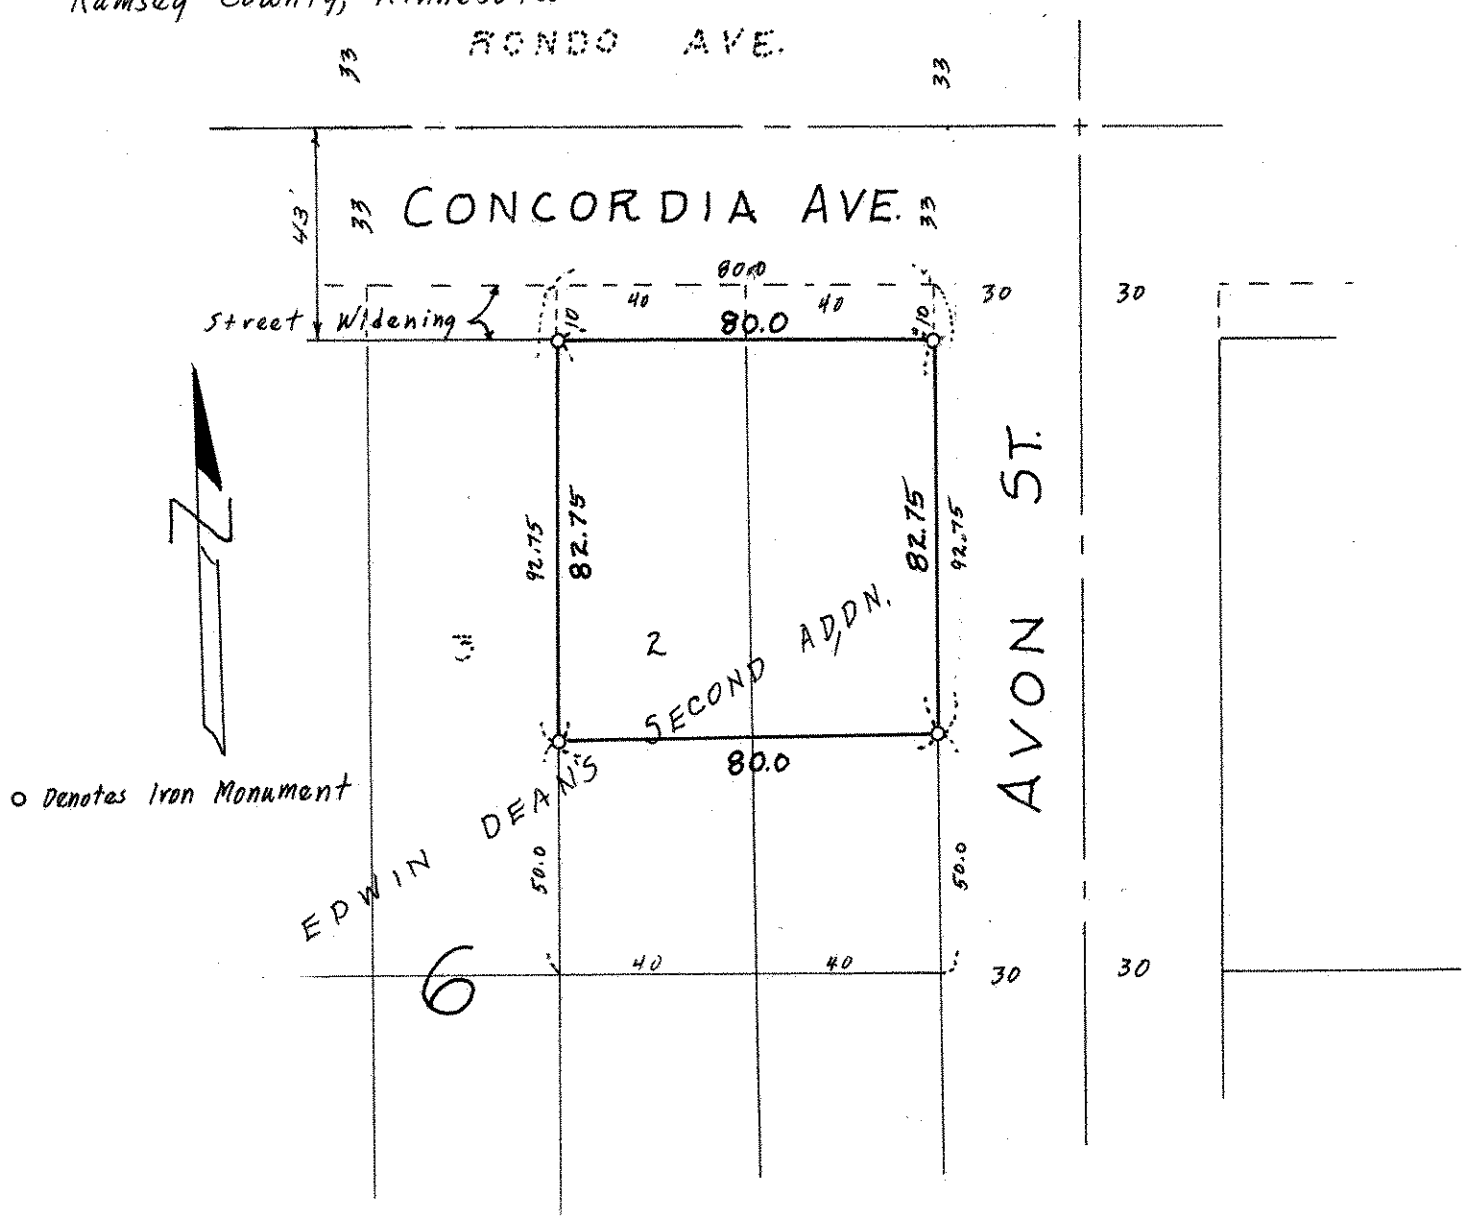
Ramsey County, Minnesota