## FROM THE OFFICE OF

## Certificate } of Survey

## **CHARLES O. GEORGI COMPANY**

2215 West County Road B

Saint Paul, Minnesota 55113

REGISTERED CIVIL ENGINEER AND LAND SURVEYOR

I Hereby Certify that this plat shows a survey made by me of the property described on this plat, and that the corners are correctly placed as shown, and that all locations have been correctly shown.

Project No. - Minn. A-1-1
Parcel 44-A
Avea: 4,571 59.ft., m.o.L.

Surveyed For Housing Authority


Date August 1973

By ....

harles beorgi REGISTERED LAND SURVEYOR

Description:

Lot 22, Block 8, Butterfield Syndicate Addition No. 1 (Registered property)

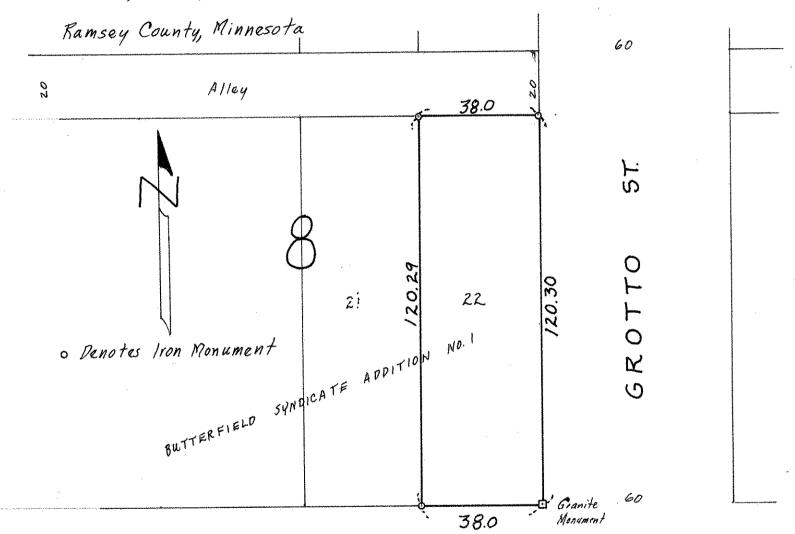

CENTRAL

AVE.

ź

Š