FROM THE OFFICE OF

CHARLES O. GEORGI COMPANY

2215 West County Road B

Saint Paul, Minnesota 55113

REGISTERED CIVIL ENGINEER AND LAND SURVEYOR

Certificate of Survey

I Hereby Certify that this plat shows a survey made by me of the property described on this plat, and that the corners are correctly placed as shown, and that all locations have been correctly shown.

Surveyed For Housing Authority


Date June 1978

Description: (Road Easement)

By Malel Camely
REGISTERED LAND SURVEYOR

Outlot A, Cantral Village Addition No. 2, except that part described

as Follows:
Commencing at the SE corner of said outlot A; thence 589°5/59"W (assumed bearing as per plat) 35.0 feet along the Southerly line of said outlot A to the point of beginning; thence continuing 589°51'59"W along said Southerly line 40.0 feet; thence No°09'17"E 92.05 feet; thence Right on a tangential curve 15.66 feet, Radius of 10.0 feet, Delta angle of 89°42'42"; thence N89°51'59"E tangent to said curve 20.0 feet; thence Right on a tangential curve 15.76 feet, Radius 10.0 feet, Delta angle 90°17'18"; thence 50°09'17"W tangent to said curve 91.95 feet to the point of beginning.

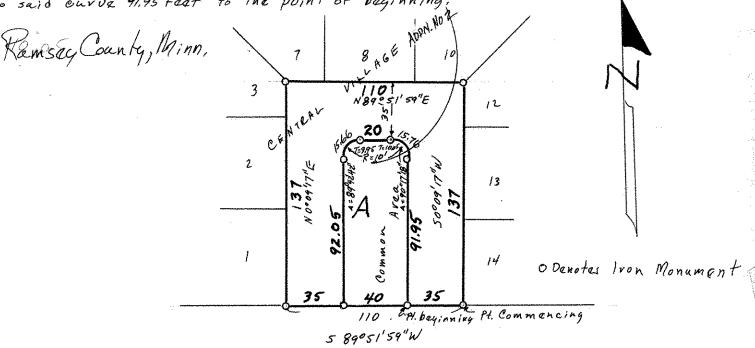

CENTRAL AVE.