SE 8 29 23

FROM THE OFFICE OF

CHARLES O. GEORGI COMPANY

2215 West County Road B Saint Paul, Minnesota 55113

REGISTERED CIVIL ENGINEER AND LAND SURVEYOR

Certificate of Survey

I Hereby Certify that this plat shows a survey made by me of the property described on this plat, and that the corners are correctly placed as shown, and that all locations have been correctly shown.

Surveyed For James Cypress Earl Nelson Bldgr

Date May 1968

Scale 1" = 50'

By Charles O. Georgi
REGISTERED LAND SURVEYOR

Description:
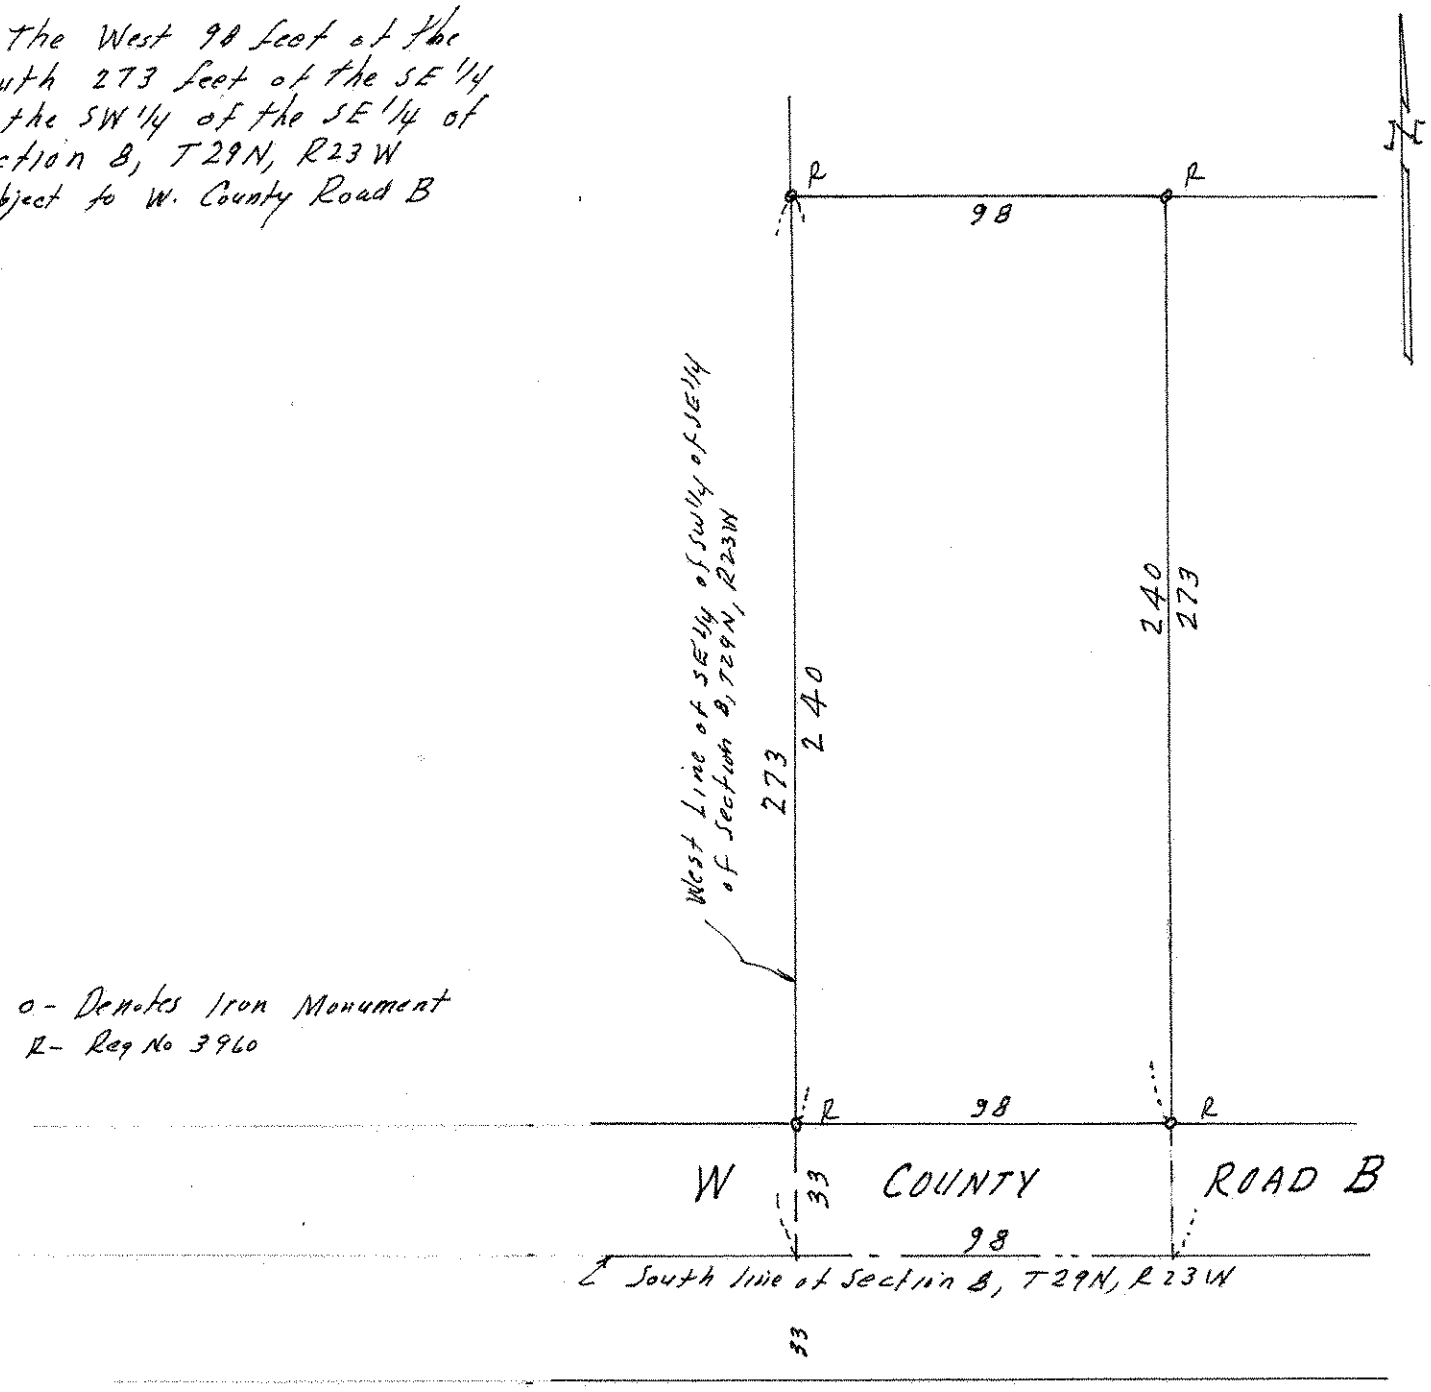
The West 98 feet of the South 273 feet of the SE 1/4 of the SW 1/4 of the SE 1/4 of Section 8, T29N, R23W subject to W. County Road B