NW 10 29 23

Certificate of Survey

From the office of

GEORGI- SCHMIDT & ASSOC. INC.

3092 No. Lexington Ave., Roseville, Mn. 55113

LAND SURVEYING

483-4408

I Hereby Certify that this plat shows a survey made by me of the property described on this plat, and that the corners are correctly placed as shown, and that all locations have been correctly shown.

Job Number: 889

Surveyed For Roland Carpenter

Date March 21, 1981

Scale 1" = 40'

By Donald W. Schmidt

REGISTERED LAND SURVEYOR

Description:

(Parcel 1) All that part Lot 25, Block 6, lying South of an easterly extension of the North line of Lot 27, Block 6, extended easterly to a point distant 13 feet West of the East line of said Lot 25; thence northeast to the southeast corner of Lot 4, in said Block 6; except the east 4 feet thereof, in Husby's Northview.

(Parcel 2) All that part of lot 26, except the westerly 23 feet thereof, block 6, of Husby's Northview lying south of an easterly extension of the north line of lot 27 in said block 6, extended to the east line of lot 26,
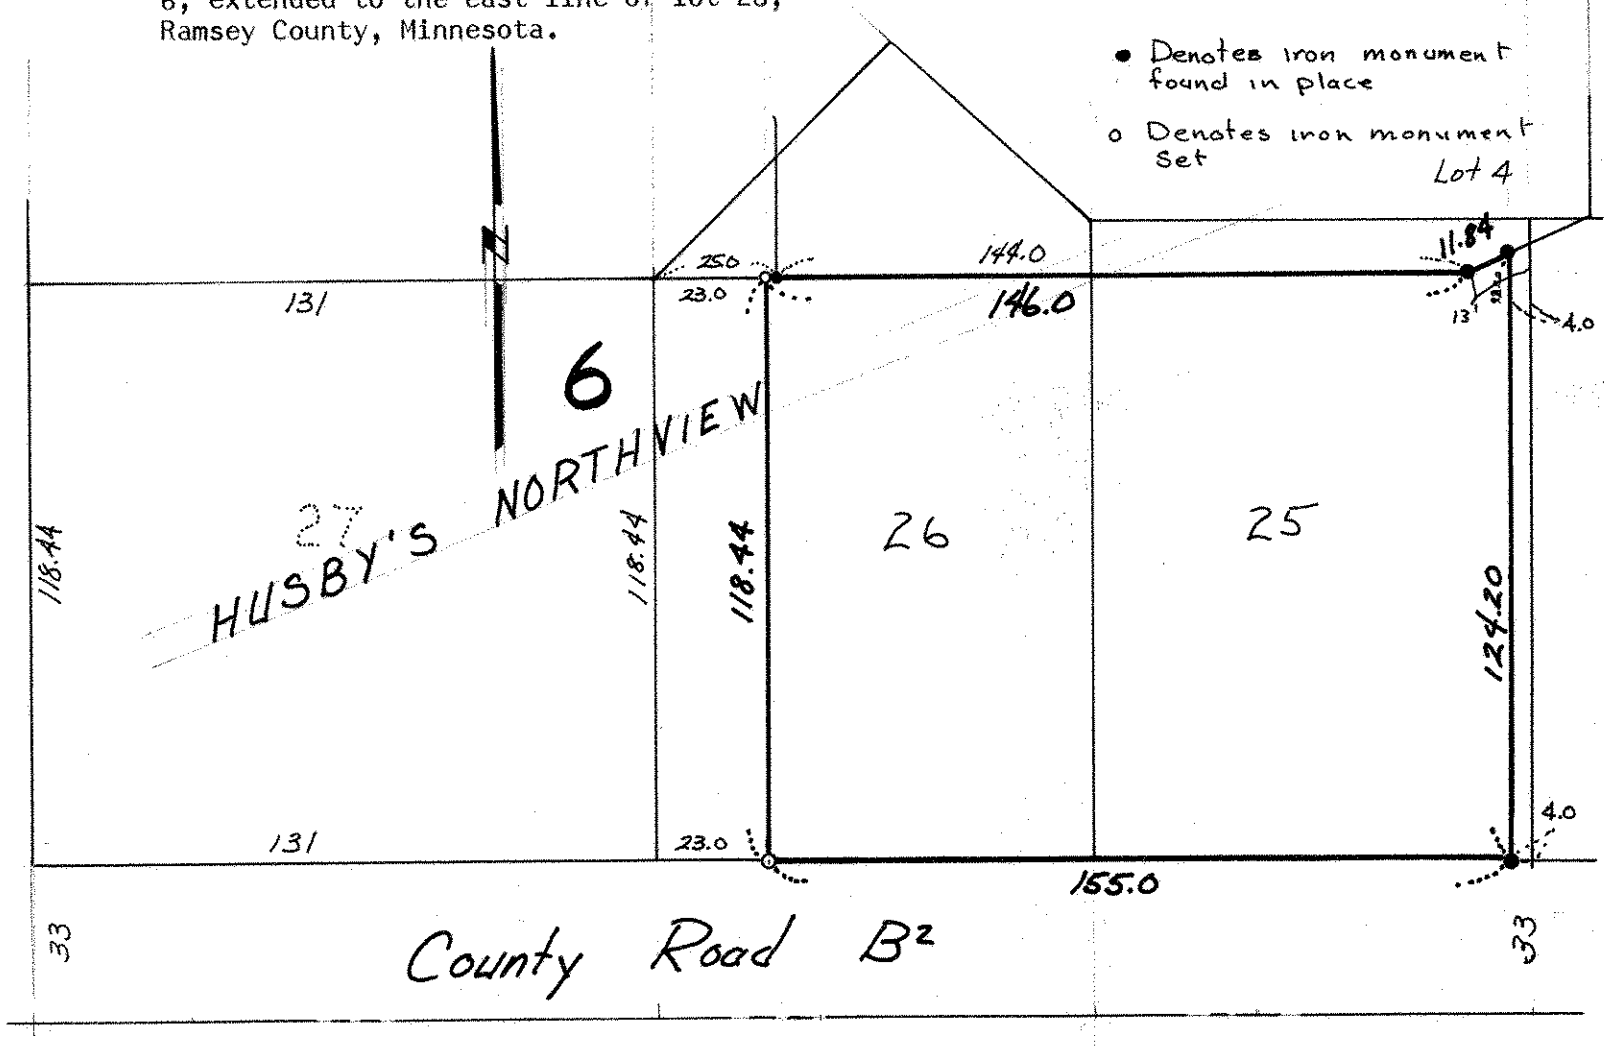
Ramsey County, Minnesota.