SW 34 29 23

Certificate of Survey

From the office of

GEORGI- SCHMIDT & ASSOC. INC.

3092 No. Lexington Ave., Roseville, Mn. 55113

LAND SURVEYING

483-4408

I Hereby Certify that this plat shows a survey made by me of the property described on this plat, and that the corners are correctly placed as shown.

Job Number: 1229

Surveyed For Montgomery Ward

Date 9/10/82

Scale 1"=50'

By Donald W. Schmidt
REGISTERED LAND SURVEYOR
RLS #10459

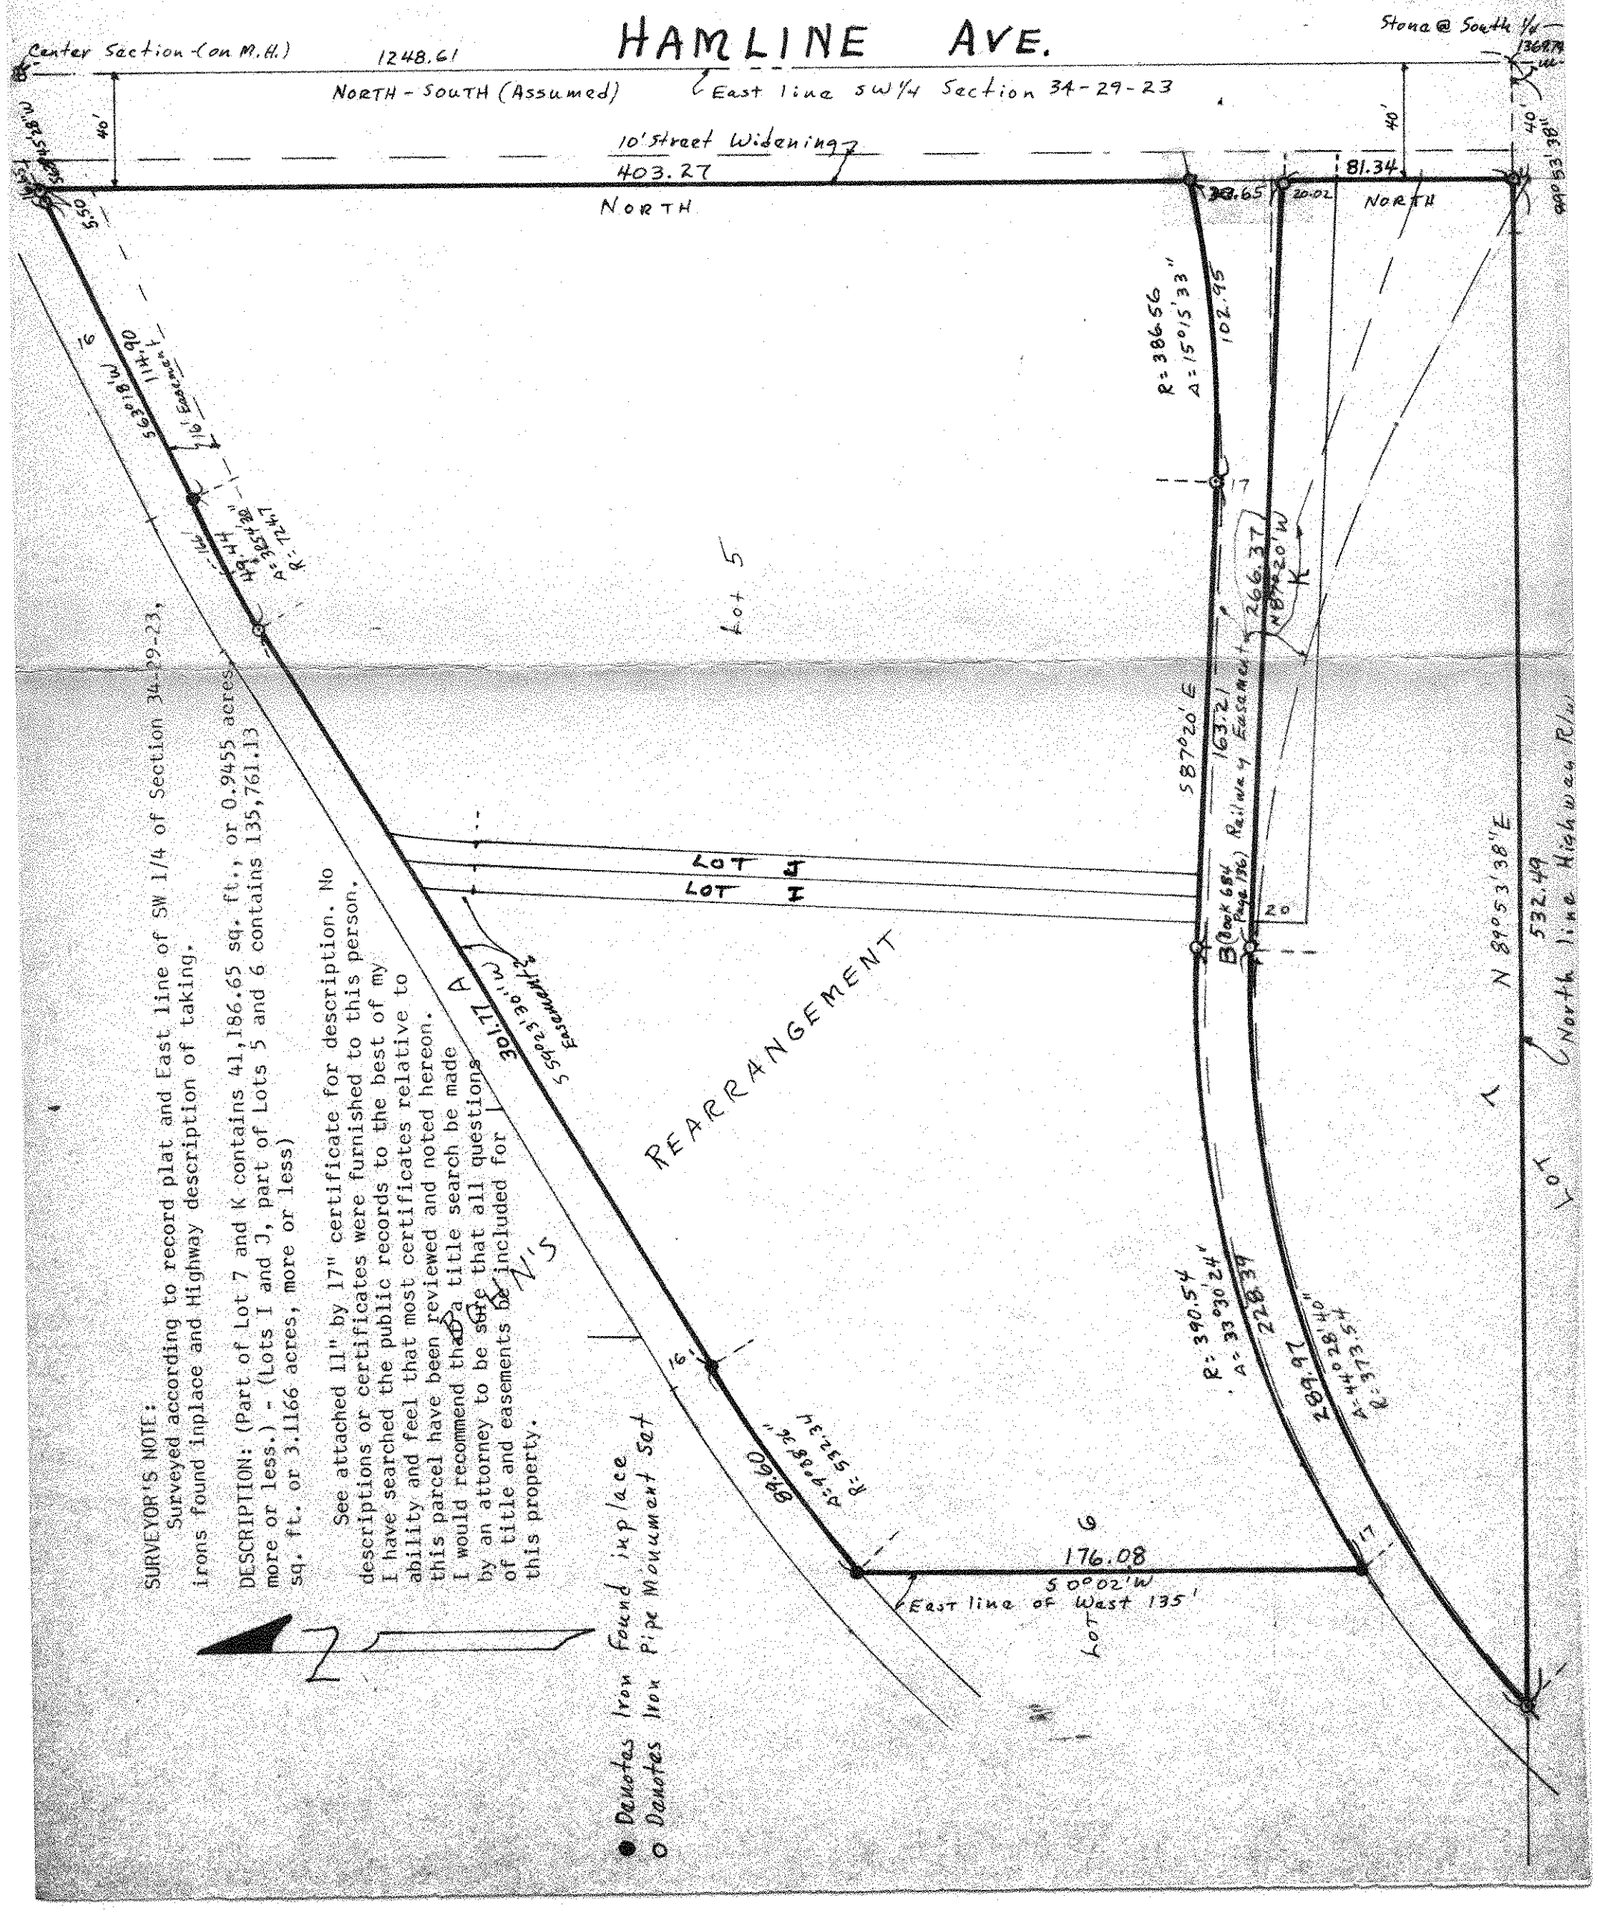

SURVEYOR'S NOTE:
Surveyed according to record plat and E
irons found inplace and Highway description

DESCRIPTION: (Part of Lot 7 and K contains 4
more or less.) - (Lots I and J, part of Lots
sq. ft. or 3.1166 acres, more or less)

See attached 11" by 17" certificate for description. No descriptions or certificates were furnished to this person. I have searched the public records to the best of my ability and feel that most certificates relative to this parcel have been reviewed and noted hereon. I would recommend that a title search be made by an attorney to be sure that all questions of title and easements be included for this property.

● Denotes iron found inplace
○ Denotes iron Pipe Monument Set