
## Certificate of Survey

From the office of

## GEORGI- SCHMIDT & ASSOC. INC.

3092 No. Lexington Ave., Roseville, Mn. 55113 LAND SURVEYING 483-4408

I Hereby Certify that this plat shows a survey made by me of the property described on this plat, and that the corners are correctly placed as shown,

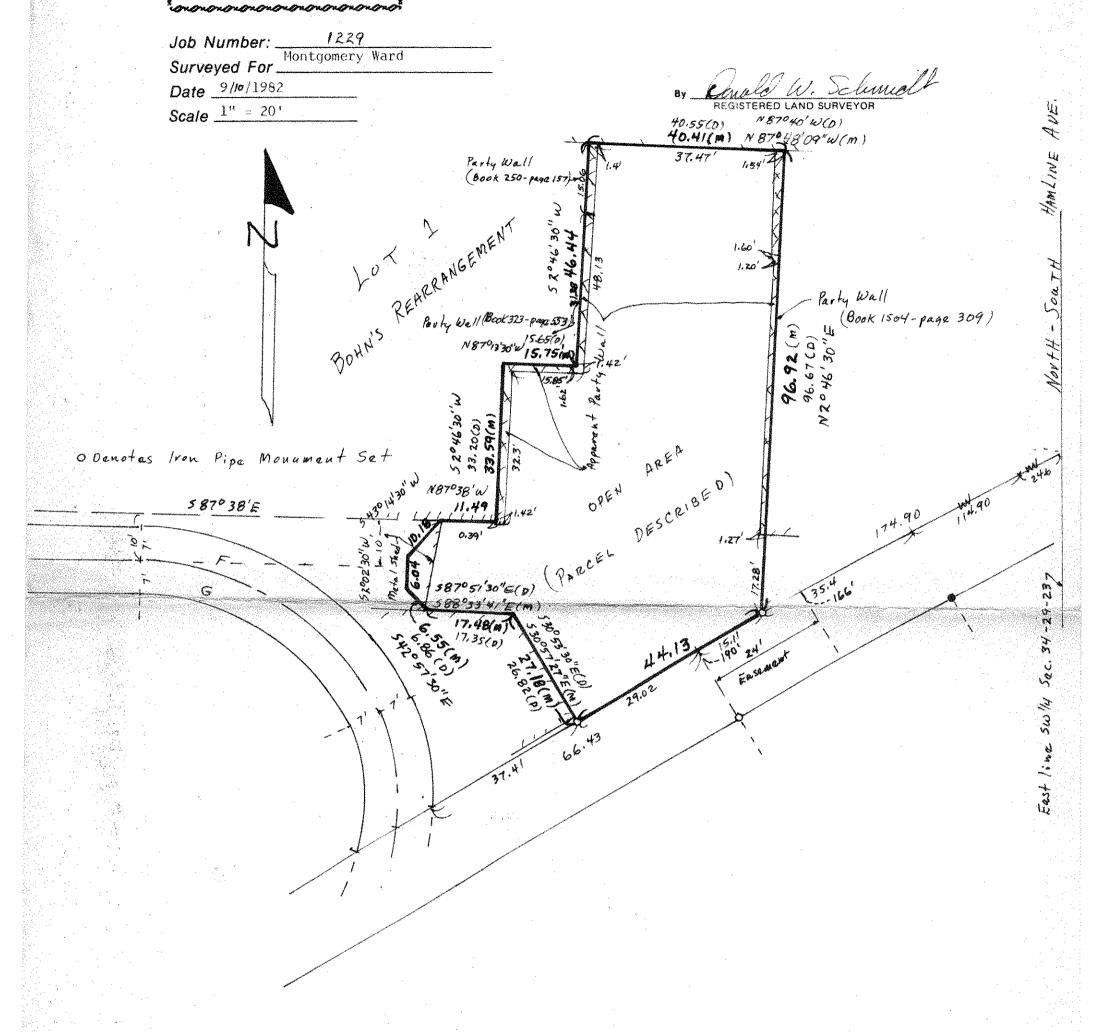

SURVEYOR'S NOTES:

- (M) =(Measured) Denotes measured bearing or distances in relation to called positions in the Deed. distances and bearings not indicated either way are deed calls.
- (D) = (Deed) Denotes deed calls for distances and bearings.

Thus: Deed calls for beginning point 174.9 feet from SE corner of Lot 1, Bohn's Rearrangement-Deed calls for point on South line Lot 1 and 37.41 feet NE of SE corner of said Lot 1 -Deed calls for going to wall and thence along face of wall

Deed calls for going to wall and thence along face of wall Deed calls for going to point of intersection with line 10 feet North of Easterly extension tangent line between Lots F and G.

Where no call seemed to agree with called for point deed call was used.

Surveyed according to recorded plat and East line of SW 1/4 of Section 34-29-23. Exact relation of shown walls and corners of described parcel is not possible because of existing walls and buildings.

DESCRIPTION: (Contains 11226.28 sq. ft., or 0.2577 acres, more or less0

See attached 11<sup>¶</sup> by 17<sup>¶</sup> for description. No descriptions or certificates were furnished to this person. I have searched the public records to the best of my ability and feel that most certificates relative to this parcel have been reviewed and noted hereon. I would recommend that a title search be made by an attorney to be sure that all questions of title and easements be included for this property.