

FROM THE OFFICE OF

CHARLES O. GEORGI COMPANY

2215 West County Road B

Saint Paul, Minnesota 55113

REGISTERED CIVIL ENGINEER AND LAND SURVEYOR



**Certificate
of Survey**

I Heroby Certify that this plat shows a survey made by me of the property described on this plat, and that the corners are correctly placed as shown, and that all locations have been correctly shown.

Surveyed For Peter Vitale


Date July 1977

Scale 1"=40'

By Charles O. Georgi
REGISTERED LAND SURVEYOR

Description:

Lots 26 & 27,
Block 4,
Midway Hills Rearrangement to Como Garden Lots,
Ramsey County, Minn.

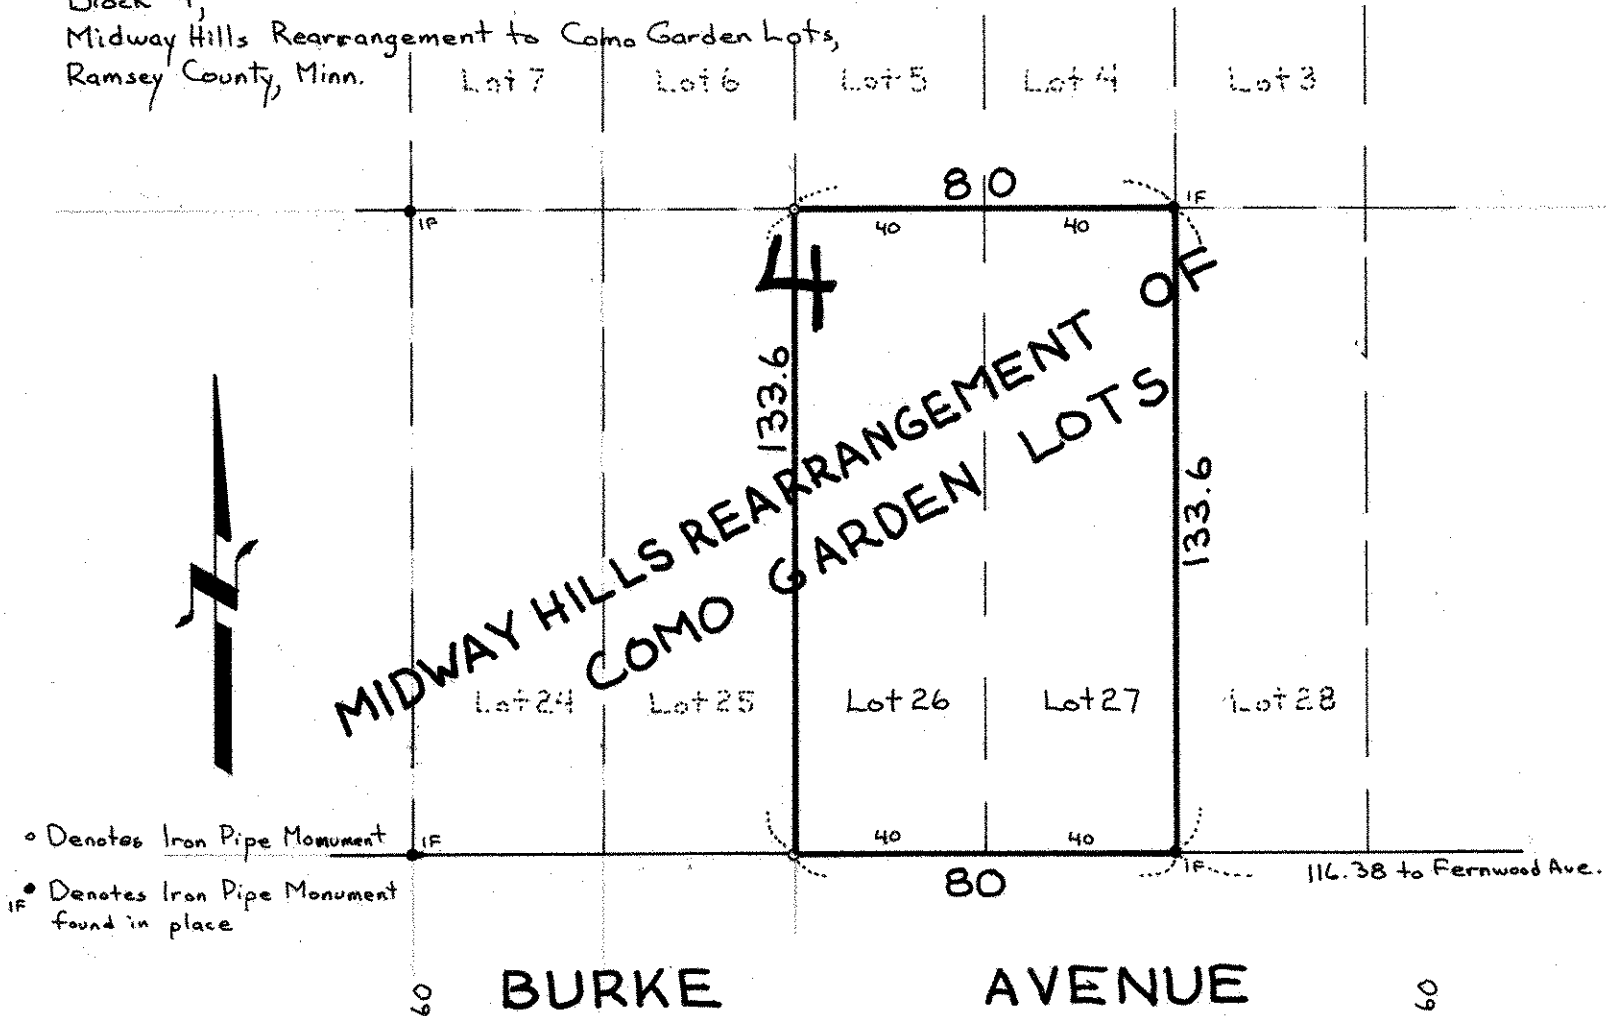

o Denotes Iron Pipe Monument
IP Denotes Iron Pipe Monument found in place