

**Certificate
of Survey**

From the office of
GEORGI-SCHMIDT & ASSOC. INC.
 3092 No. Lexington Ave., Roseville, Mn. 55113
 LAND SURVEYING
 483-4408

I Hereby Certify that this plat shows a survey made by me of the property described on this plat, and that the corners are correctly placed as shown,

Job Number: 1673

Surveyed For Fay Thompson


Date 9/24/84

Scale 1" = 40'

By _____
 REGISTERED LAND SURVEYOR

Description:

Lot 11, Block 2, Gottfried
 Ramsey County, MN.

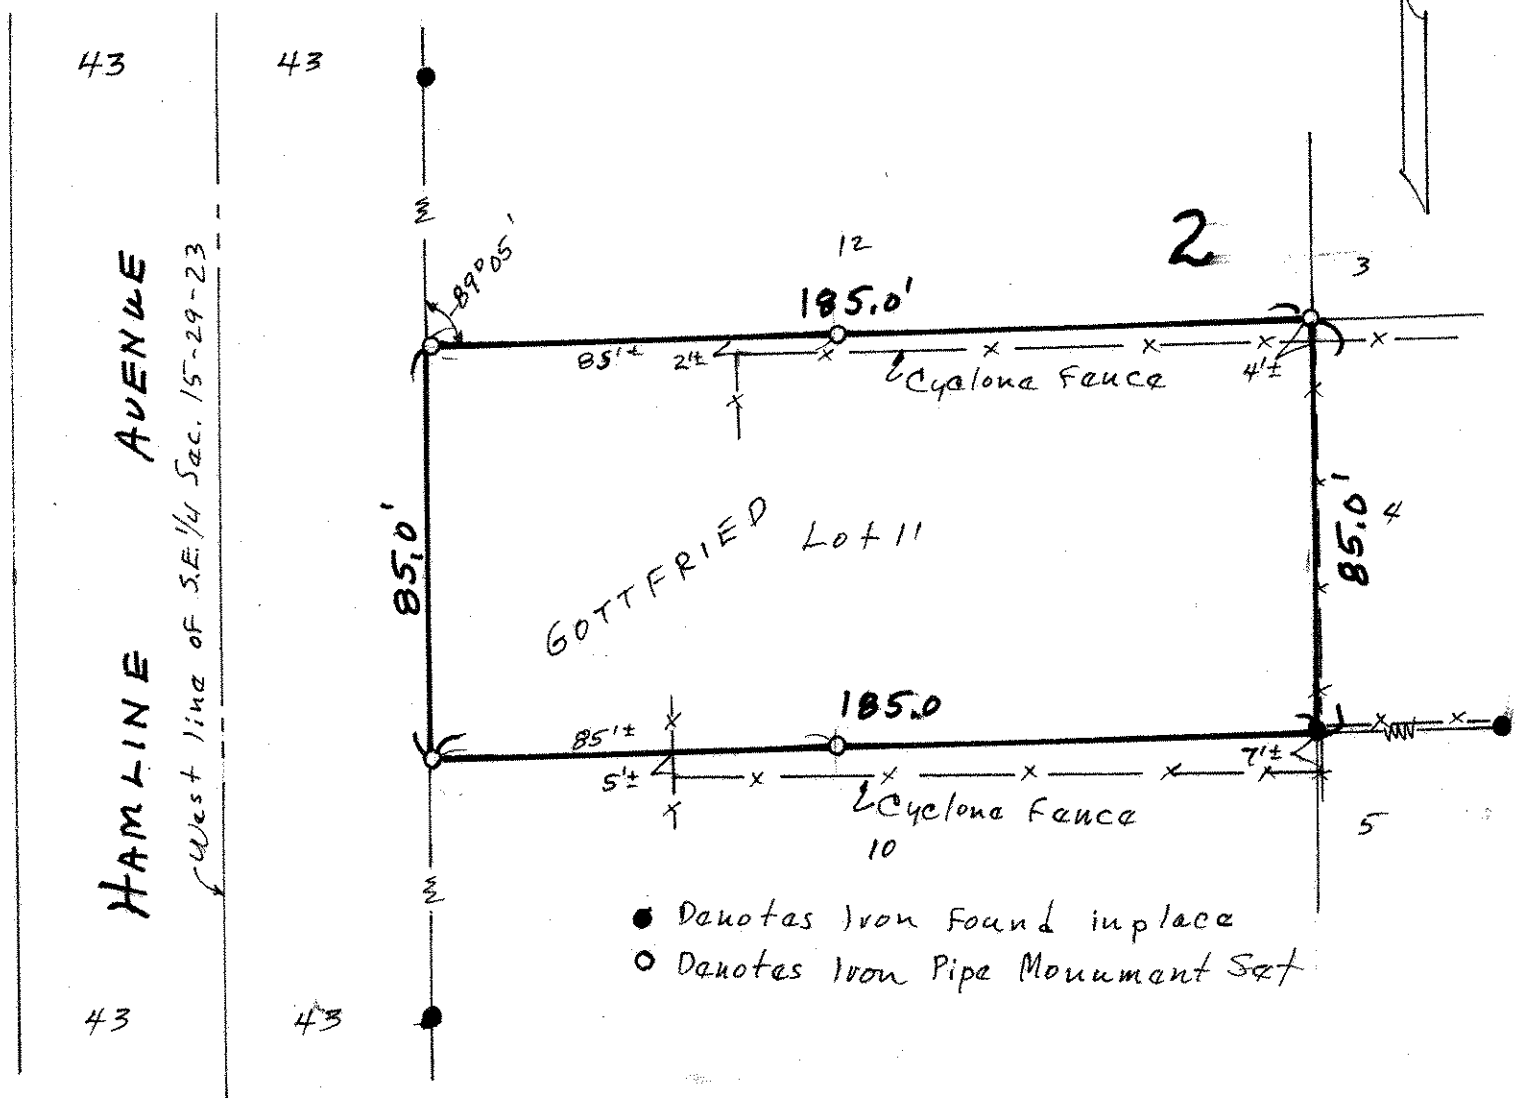

- Denotes Iron Found in place
- Denotes Iron Pipe Monument Set