NE 24 29 23

Certificate of Survey

From the office of

GEORGI- SCHMIDT & ASSOC. INC.

3092 No. Lexington Ave., Roseville, Mn. 55113

LAND SURVEYING

483-4408

I Hereby Certify that this plat shows a survey made by me of the property described on this plat, and that the corners are correctly placed as shown, and that all locations have been correctly shown.

Job Number: 59

Surveyed For John Strommer

Date August 4-1978

Scale 1"= 40'

By Donald W Schmidt
REGISTERED LAND SURVEYOR

Description:

Lots 19, 20, and 21, Block 8, Rice St. Villas
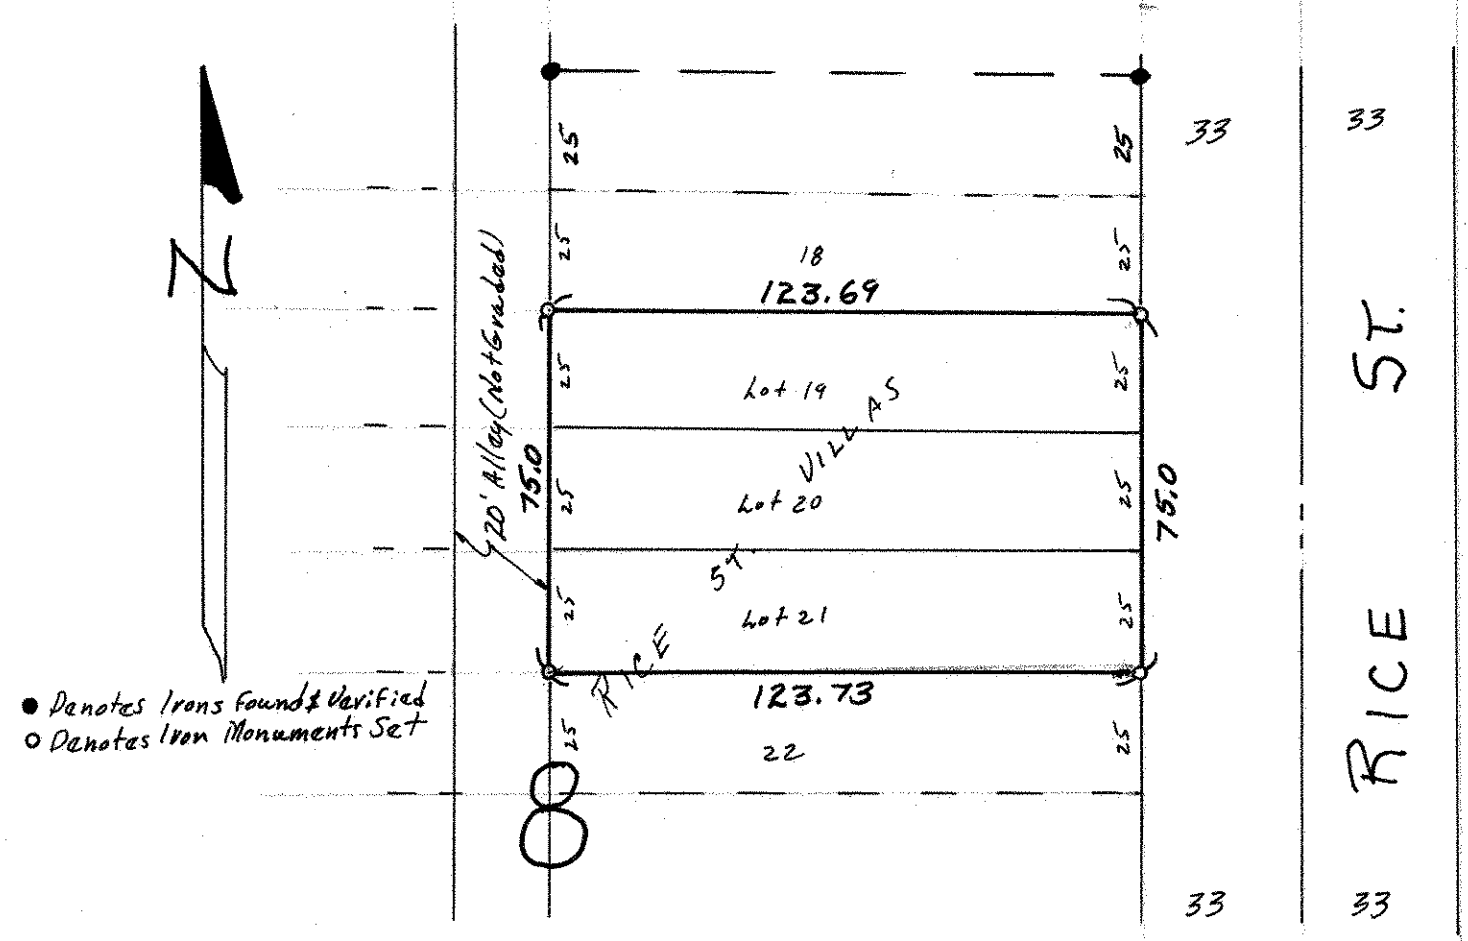
Ramsey County, MN.