SW 172923

FROM THE OFFICE OF

CHARLES O. GEORGI COMPANY

2215 West County Road B Saint Paul, Minnesota 55113

REGISTERED CIVIL ENGINEER AND LAND SURVEYOR

Certificate of Survey

I Hereby Certify that this plat shows a survey made by me of the property described on this plat, and that the corners are correctly placed as shown, and that all locations have been correctly shown. See Note.
Added House location's 10/14/69

Surveyed For George Nixa

Date September 1969

Scale 1" = 50'

By Charles O. Georgi
REGISTERED LAND SURVEYOR

Description:
Lot 25 and 26,
Block 5,
Lauderdale's East Side Addition to Minneapolis
Ramsey County, Minn.

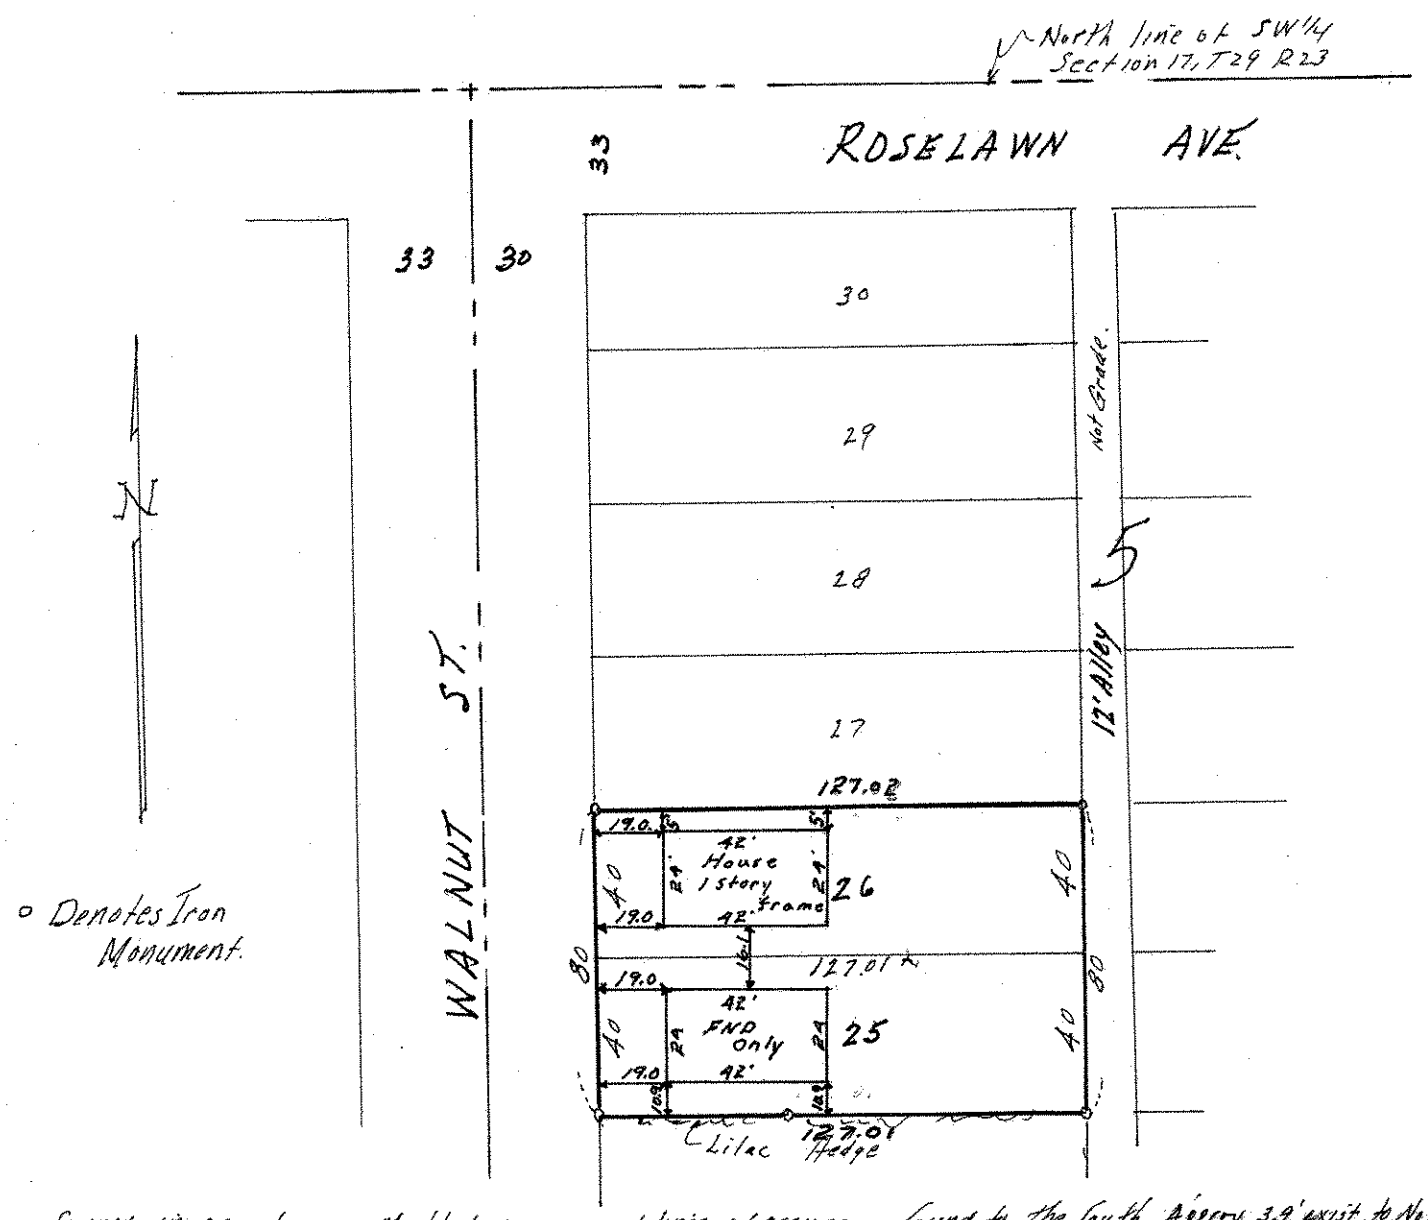

Survey in accordance with block corners and lines of occupancy found to the South. Approx. 3.9' exist to North.