NW 2, 29, 23

FROM THE OFFICE OF

CHARLES O. GEORGI COMPANY

2215 West County Road B — Saint Paul 8, Minnesota

REGISTERED CIVIL ENGINEER AND LAND SURVEYOR

Certificate of Survey

I Hereby Certify that this plat shows a building location survey made by me on the property described on this plat, and that all locations, have been correctly shown.

Date August 1964

Scale 1" = 100'

By Charles O. Georgi
REGISTERED LAND SURVEYOR

James Patterson

Description:

Part Released
The South 90 feet of Lot 20, St. Paul Park

The North 120 feet of the South 210 feet of Lot 20, St. Paul Park.
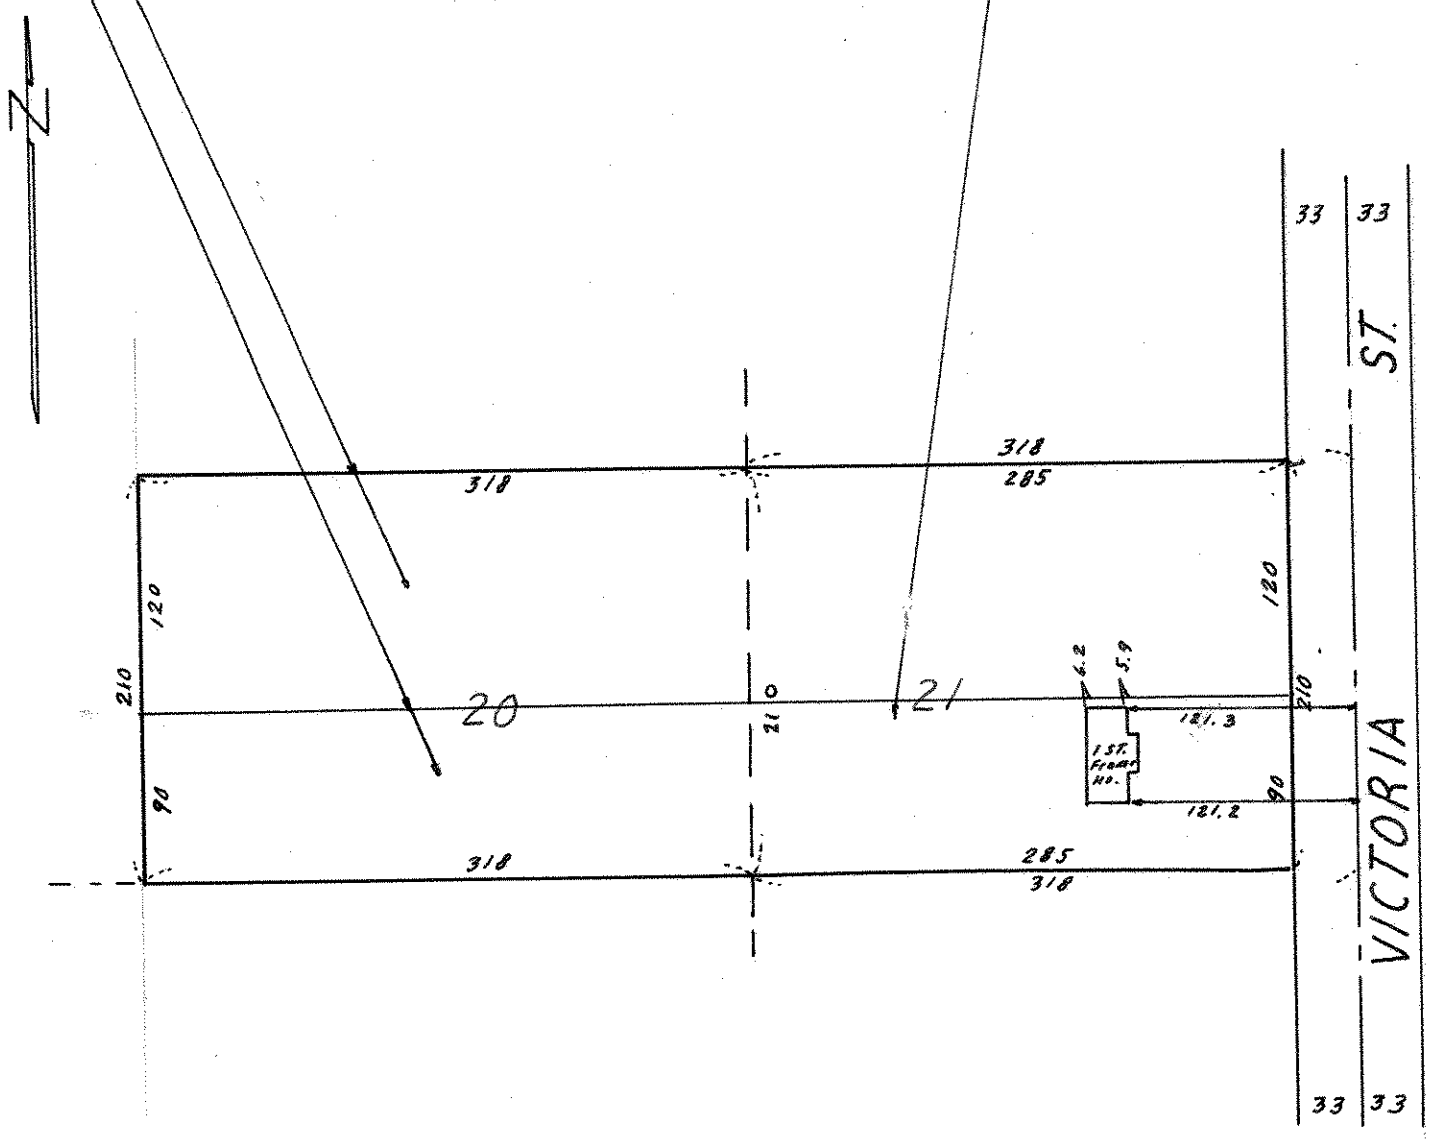
Part Retained
The South 90 feet of Lot 21, St. Paul Park.