SW 17 29 23

Certificate of Survey

From the office of

GEORGI- SCHMIDT & ASSOC. INC.

3092 No. Lexington Ave., Roseville, Mn. 55113

LAND SURVEYING

483-4408

I Hereby Certify that this plat shows a survey made by me of the property described on this plat, and that the corners are correctly placed as shown, and that all locations have been correctly shown.

Job Number: 340

Surveyed For Donna Parry

Date May 1979

Scale 1" = 40'

By Donald W. Schmidt

REGISTERED LAND SURVEYOR

Description:

The North 10 feet of the South 20 feet of Lot 2, Block 5, Lauderdale's East Side Addition to Minneapolis.

Ramsey County, Minn.

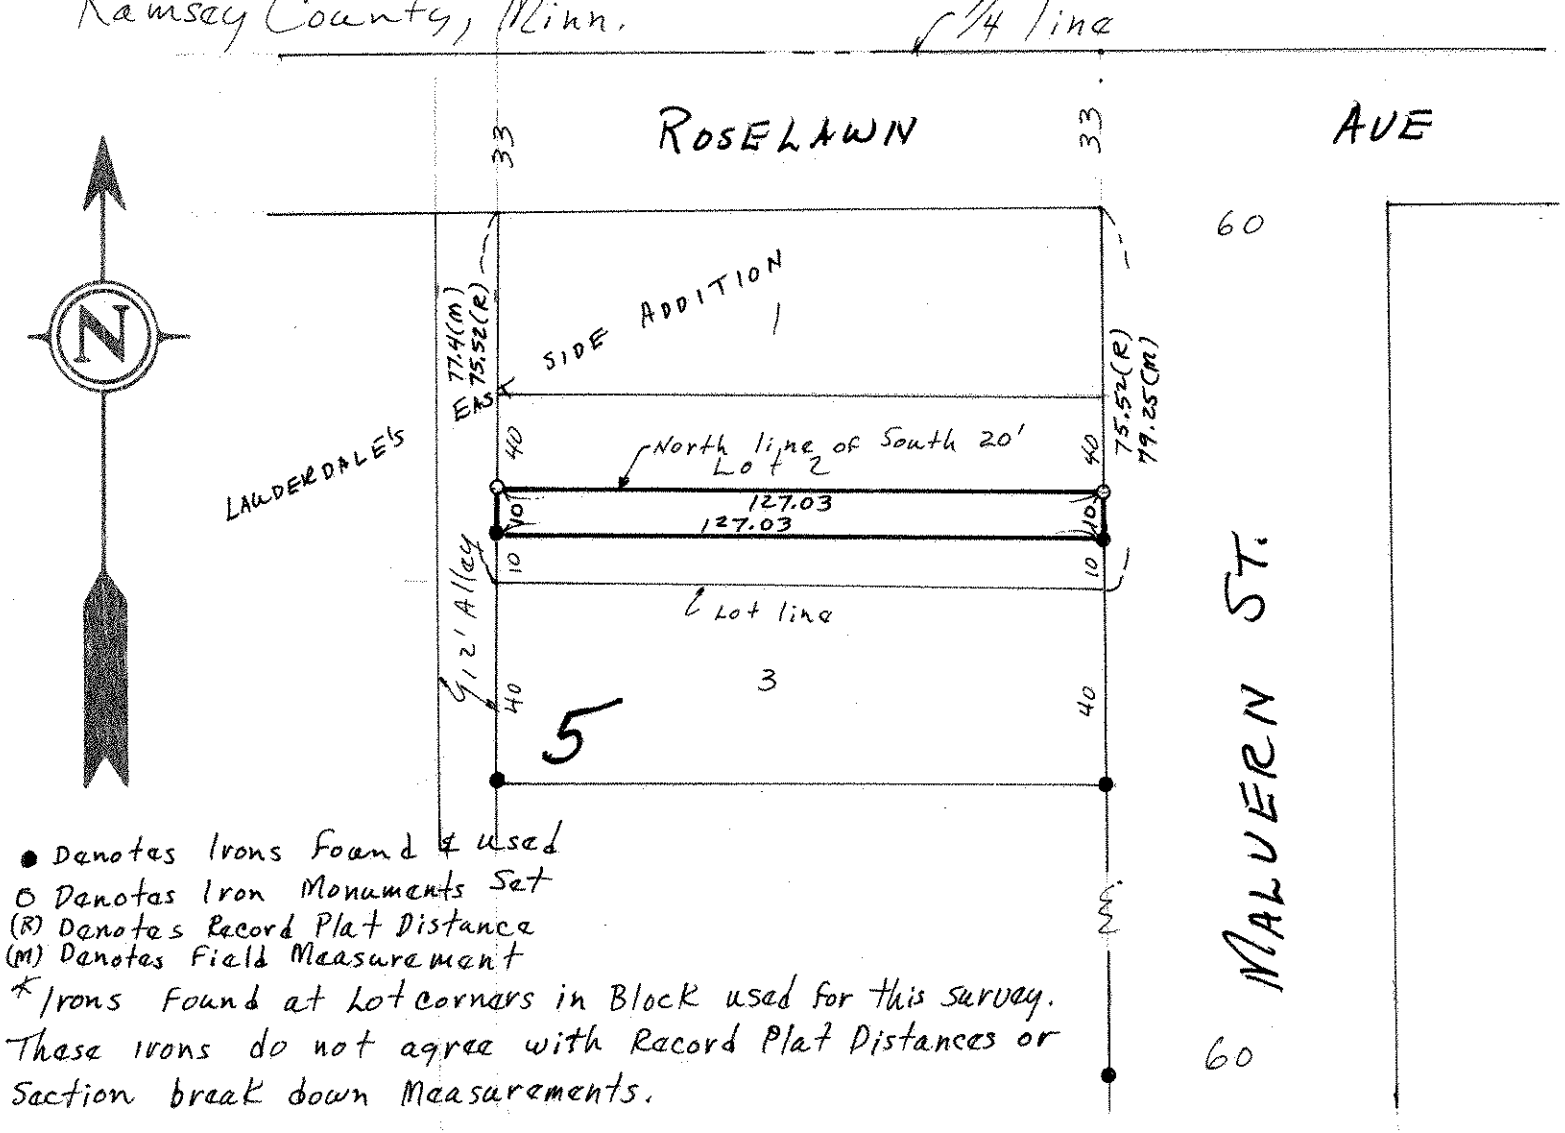

● Denotes Irons Found & used

O Denotes Iron Monuments Set

(R) Denotes Record Plat Distance

(M) Denotes Field Measurement

* Irons Found at Lot corners in Block used for this survey. These irons do not agree with Record Plat Distances or Section break down Measurements.