SE 4 29 23

FROM THE OFFICE OF

CHARLES O. GEORGI COMPANY

2215 West County Road B Saint Paul, Minnesota 55113

REGISTERED CIVIL ENGINEER AND LAND SURVEYOR

Certificate of Survey

I Hereby Certify that **this plat shows a survey made by me of the property described on this plat, and that the corners are correctly placed as shown, and that all locations have been correctly shown.**

Surveyed For Parranto Inc.

Date March 1977

Scale 1" = 100'

By Charles O. Georgi
REGISTERED LAND SURVEYOR

Description:
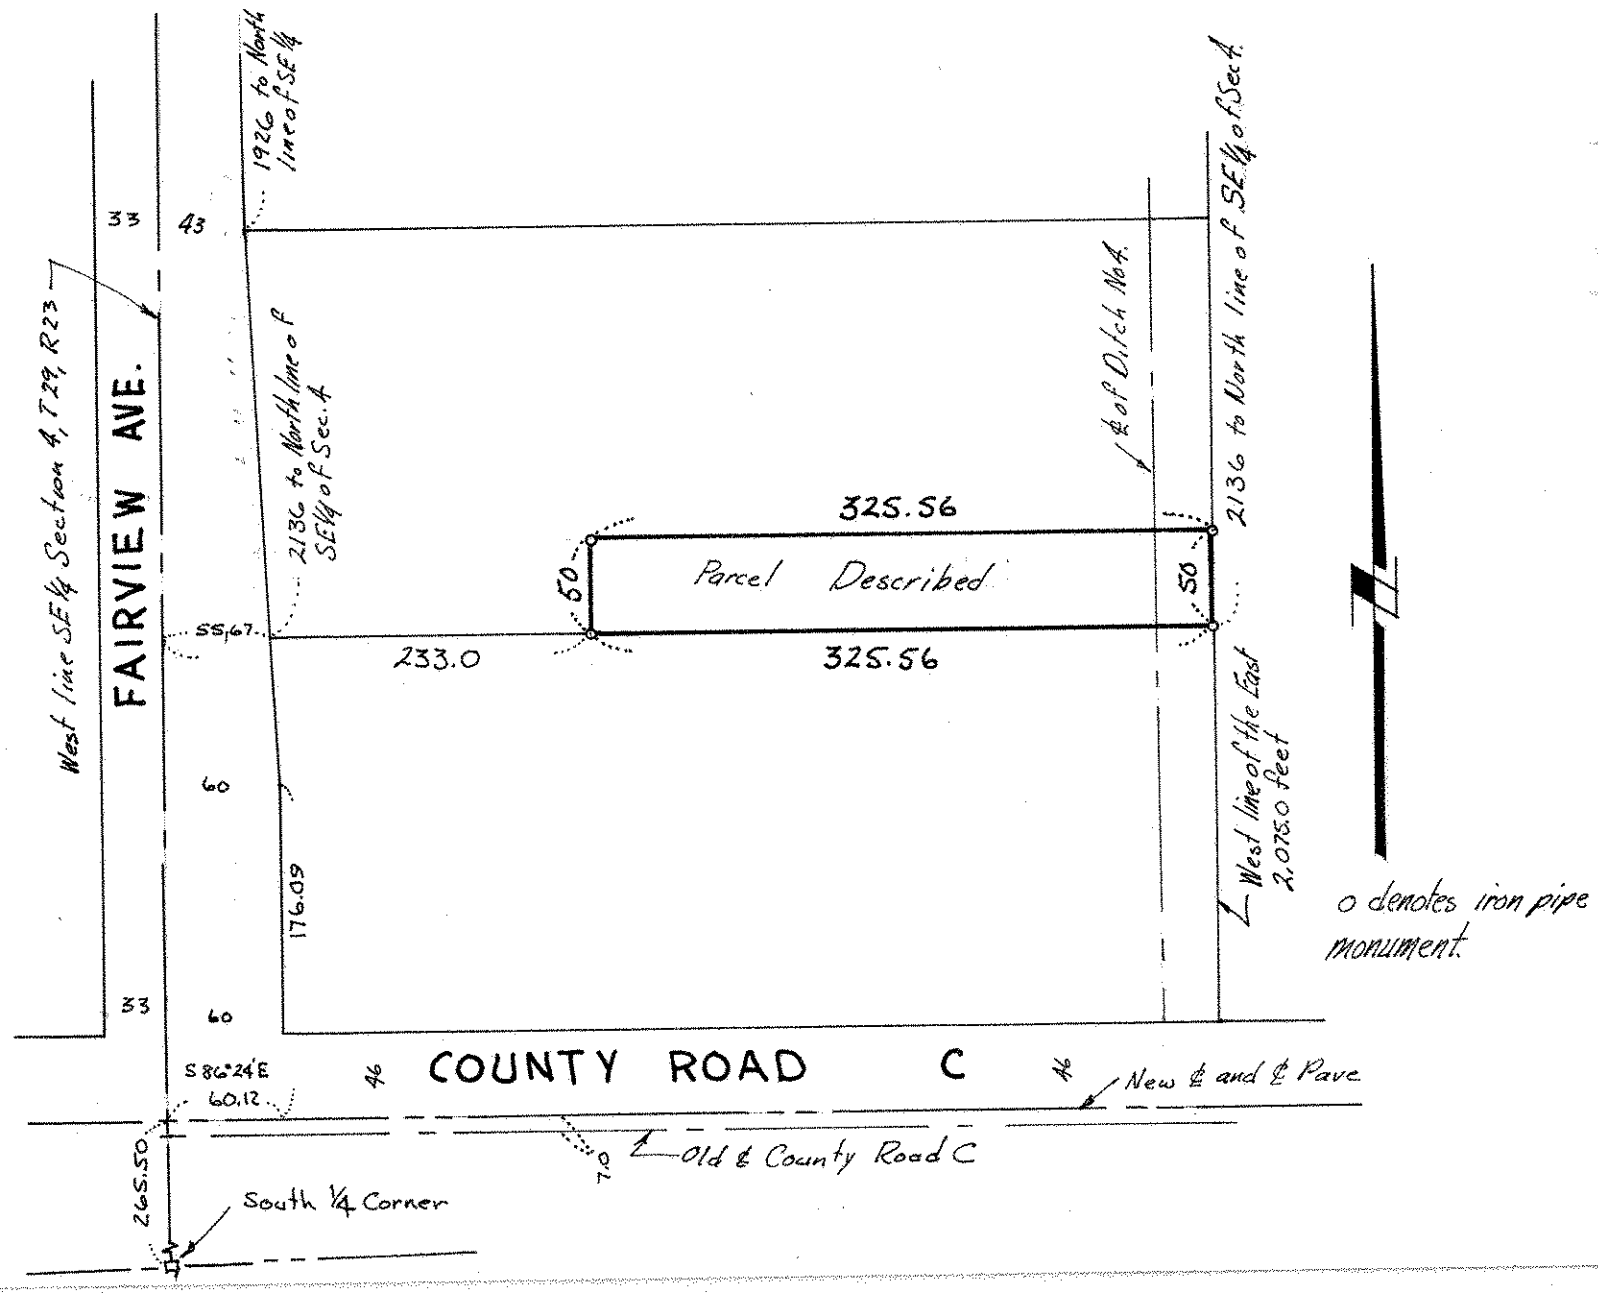
The South 50.0 feet of the North 2136.0 feet of that part of the S.E. ¼ of Section 4, T29N, R23W, lying West of the East 2,075.0 feet thereof, except the West 233 feet thereof Subject to County ditch No.4