N½ 5 29 23

FROM THE OFFICE OF

CHARLES O. GEORGI COMPANY

2215 West County Road B Saint Paul, Minnesota 55113

REGISTERED CIVIL ENGINEER AND LAND SURVEYOR

Certificate of Survey

I Hereby Certify that this plat shows a survey made by me of the property described on this plat, and that the corners are correctly placed as shown, and that all locations have been correctly shown.

Surveyed For Minnesota Transfer Railway Company

Date November 1970

Scale 1" =

By Charles O. Georgi
REGISTERED LAND SURVEYOR

Description:

The South 413 feet of the North ½ of Section 5, T29N, R23W, lying Easterly of Long Lake Road and Westerly of the Minnesota Transfer Railway Company's main line right-of-way; subject to County Road C² and easements of record.

Contains: 300,180 Sq.Ft. more or less
6.891 Acres, more or less.
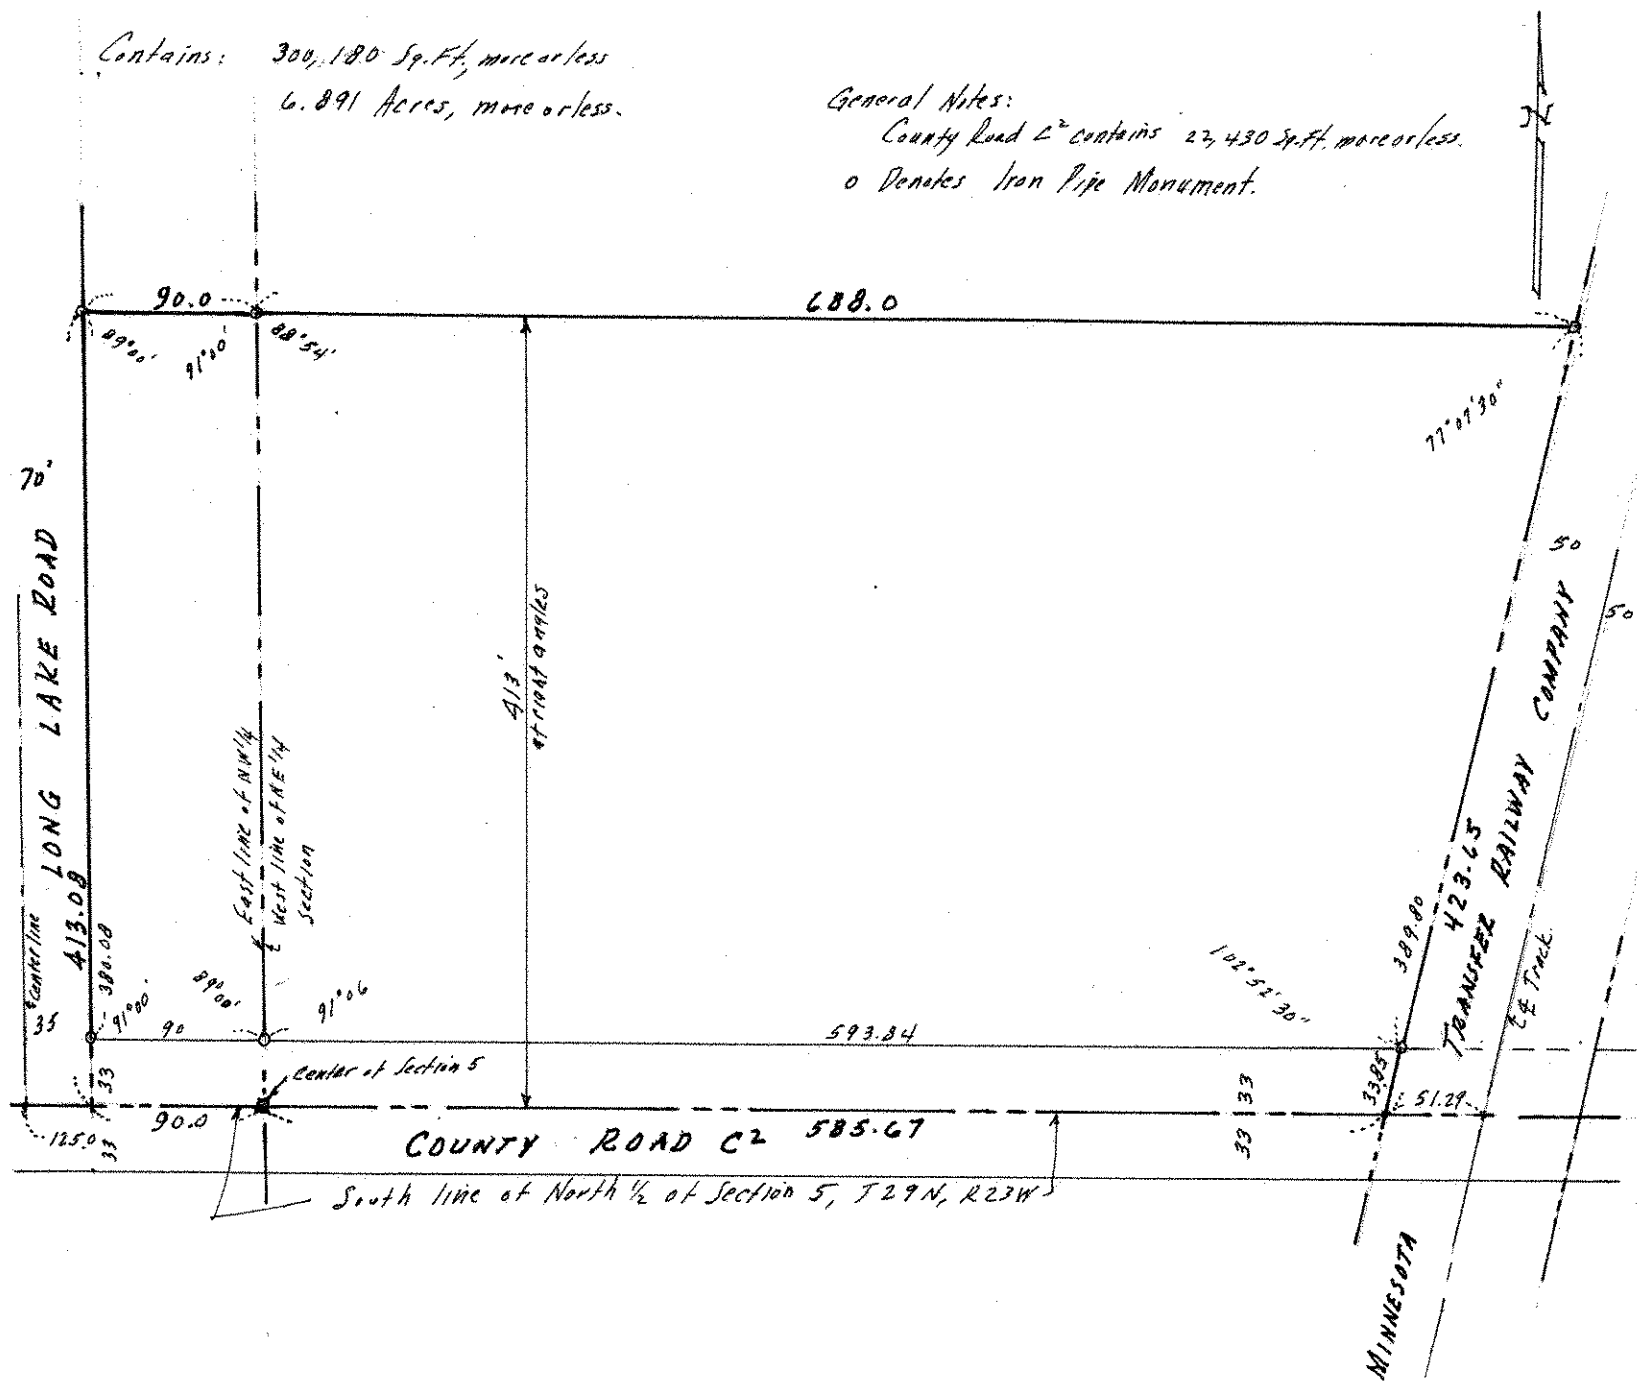
General Notes:
County Road C² contains 22,430 Sq.Ft. more or less.
o Denotes Iron Pipe Monument.