

# Certificate of Survey

From the office of  
**GEORGI-SCHMIDT & ASSOC. INC.**  
3092 No. Lexington Ave., Roseville, Mn. 55113  
LAND SURVEYING  
483-4408

I Hereby Certify that this plat shows a survey made by me of the property described on this plat, and that the corners are correctly placed as shown,

Job Number: 1579

Surveyed For Dolores A. Murphy


Date 4/20/84

Scale 1" = 40'

By \_\_\_\_\_  
REGISTERED LAND SURVEYOR  
#10459

**Description:**

Lot 22, Block 2, Kroiss Lakeview Addition  
Ramsey County, Minnesota

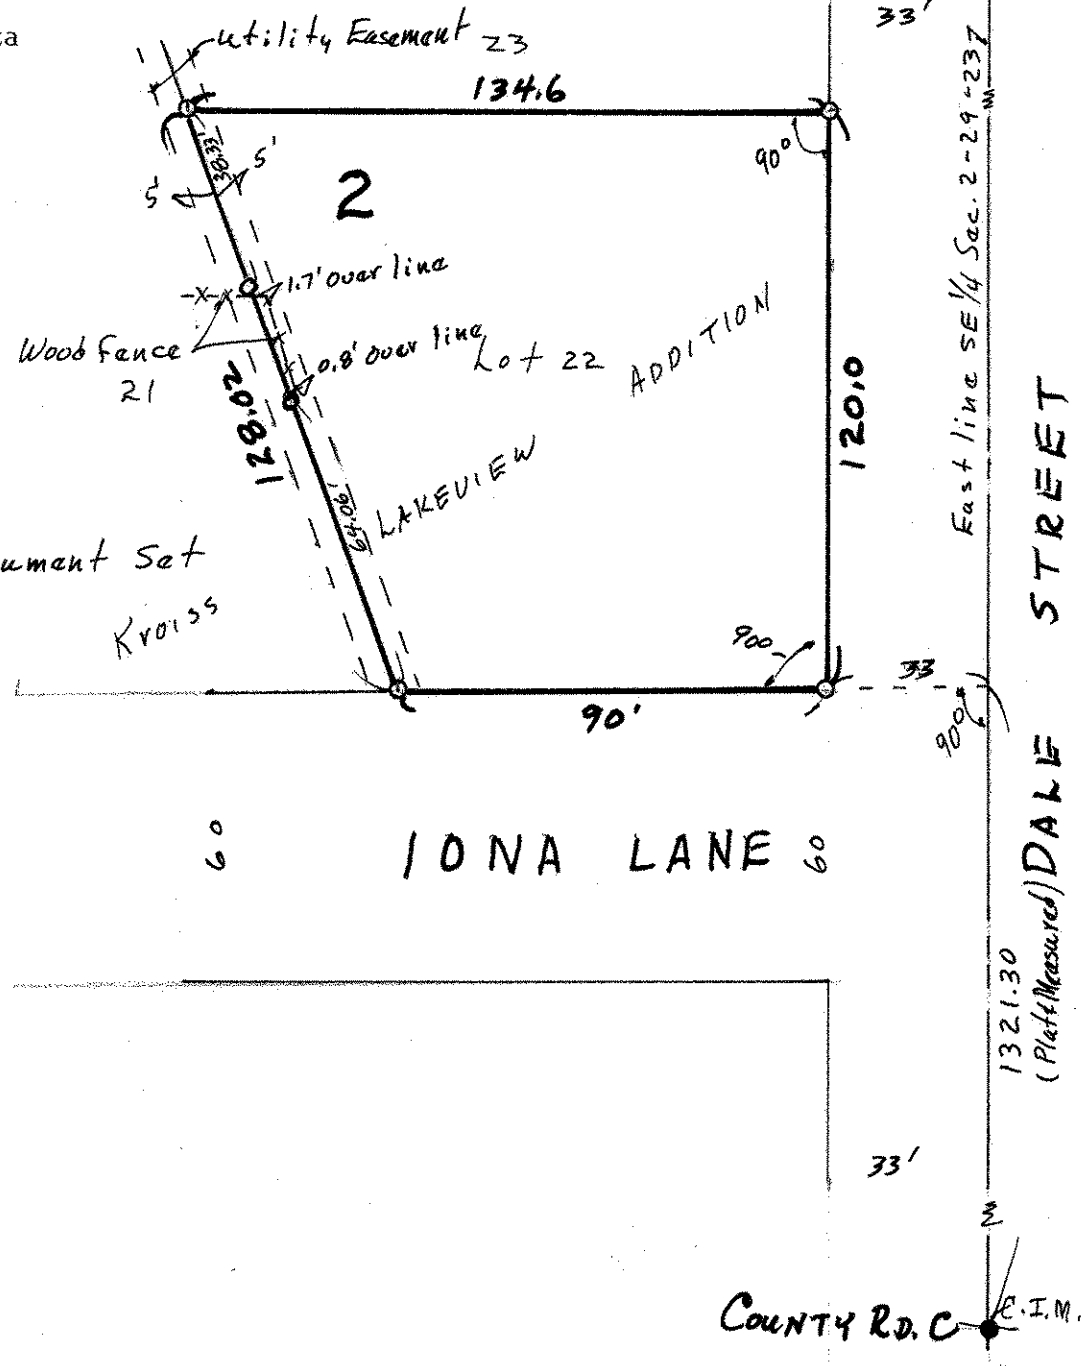

o Denotes Iron Pipe Monument Set  
Kroiss

